Section No.

Section No.

Section No.

Section No. Section No.

Section No.

Section No.

TOTAL SHEETS =

ORDER OF SHEETS STATE OF WISCONSIN Section No. DEPARTMENT OF TRANSPORTATION Section No. Typical Sections and Details Estimate of Quantities

EXCEPTION TO NET C/L LENGTH

T-31-N T-30-N MARATHON COUNTY

STA. 175+70 - STA. 178+70

STRUCTURE P-37-910

PLAN OF PROPOSED IMPROVEMENT

CTH H - CTH S

TOWN OF HALSEY

CTHF MARATHON COUNTY

STATE PROJECT NUMBER

9478-05-70

CORN

REIMER RD

REVISIONS: SHEETS #4, #9, #11, #12, #15, and #16

HALSEY

PROJECT LOCATION EXCEPTION TO NET C/L LENGTH **DESIGN DESIGNATION** STA. 143+14 - STA. 147+59

Miscellaneous Quantities

Standard Detail Drawings

Computer Earthwork Data

Plan and Profile (Includes Erosion Control Plan)

Right of Way Plat

Sign Plates

Structure Plans

Cross Sections

A.A.D.T.	2014	=	570
A.A.D.T.	2034	=	850
D.H.V.	2034	=	140
D.D.		=	62/38
Т.		=	4.0%
DESIGN S	PEED	=	55 M.P.

ESALS = 58,400

CONVENTIONAL SYMBOLS


PLAN CORPORATE LIMITS PROPERTY LINE


LOT LINE LIMITED HIGHWAY EASEMENT EXISTING RIGHT OF WAY PROPOSED OR NEW R/W LINE SLOPE INTERCEPT

REFERENCE LINE EXISTING CULVERT PROPOSED CULVERT COMBUSTIBLE FLUIDS

MARSH AREA

WOODED OR SHRUB AREA

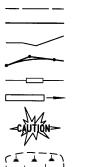

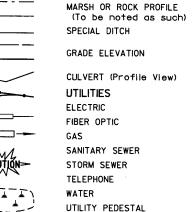


POWER POLE


TELEPHONE POLE


PROFILE

GRADE LINE

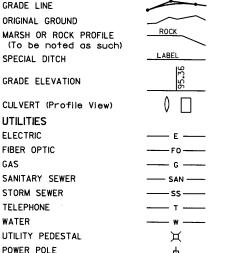

STRUCTURE B-37-415

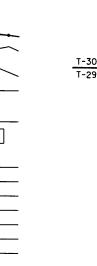

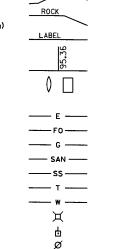


BEGIN PROJECT

STA. 100+75

Y= 244,758.69

X= 184,344.32

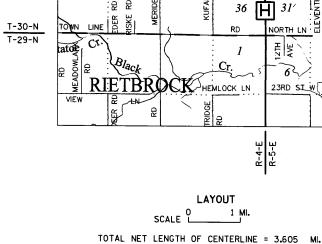

"COORDINATES ON THIS PLAN ARE REFERENCED TO THE WISCONSIN COUNTY COORDINATE SYSTEM (WCCS), MARATHON COUNTY"

END PROJECT

STA. 301+55

FEDERAL PROJECT STATE PROJECT PROJECT 9478-05-70

AS-BUILT PLAN

SUPERVISOR: Lynn Saeger, WisDOT PROJECT MANAGER: Mike Roberts

DAAR Engineering, Inc.

PROJECT LEADER: Mathew D. Adams

Fleming, Andre & Associates, Inc.

CONTRACTOR: Marathon County

Highway Department

WORK STARTED: 05/27/2014 WORK COMPLETED: 08/01/2014 EXCEPTION TO NET C/L LENGTH

FINAL CONTRACT COST: SUBCONTRACTORS:

Century Fence Company





STATE OF WISCONSIN DEPARTMENT OF TRANSPORTATION

PREPARED BY

JEWELL ASSOCIATES ENGINEERS, INC. JEWELL ASSOCIATES ENGINEERS, INC.

ent Consultant ____CEDAR CORPORATION

APPROVED FOR THE DEPARTMENT DATE: 12-18 2013

STA. 249+01 - STA. 252+00

LINCOLN COUNTY

T-30-N MARATHON COUNTY

T-30-N

T-29-N

STRUCTURE B-37-419

Cr.

Hamburg

HAMBURG

NORTH

Einert

RIB

Grass E

) ♡

TELEPHONE/FIBER OPTIC FRONTIER COMMUNICATIONS

1851 N 14TH AVENUE WAUSAU, WI 54401 ATTN: WARREN INMAN PH: (715) 847-1504

UTILITIES

EMAIL: warren.e.inman@ftr.com

ELECTRIC

WISCONSIN PUBLIC SERVICE CORP. 3200 EAST MAIN STREET MERRILL, WI 54452 ATTN: MICHAEL A. REHWINKEL PH: (715) 539-4021 FAX: (715) 539-4055

EMAIL: marehwinkel@wisconsinpublicservice.com

ELECTRIC

TAYLOR ELECTRIC COOPERATIVE N 1831 STATE HWY 13 MEDFORD, WI 54451 ATTN: KEVIN COMSTOCK PH: (800) 862-2407 EMAIL: kevin@taylorelectric.org

MARATHON COUNTY HIGHWAY DEPARTMENT

EMAIL: jmgriesbach@mail.co.marathon.wi.us

INL

INV

Inlet

Invert

Inside Diameter

CONTACTS

DESIGN CONSULTANT: JEWELL ASSOCIATES ENGINEERS, INC. 310 EAST JACKSON STREET WISCONSIN RAPIDS, WI 54494 ATTN: FRED GRUBER, P.E. PH: (608) 588-7484 CELL: (608) 341-8194 FAX: (608) 588-9322 E-MAIL: fred.gruber@jewellassoc.com

WDNR LIASON:

STATE OF WISCONSIN DEPT. OF NATURAL RESOURCES WEST CENTRAL REGIONAL OFFICE 47.3 GRIFFITH AVENUE WISCONSIN RAPIDS, WI 54494 ATTN: MARC HERSHFIELD PH: (715) 421-7867 (715) 421-7830 E-MAIL: marc.hershfield@wisconsin.gov

1430 WEST STREET WAUSAU, WI 54401-5342 ATTN: JIM GRIESBACH PH: (715) 261–1801 FAX: (715) 261–1810

LIST OF STANDARD ABBREVIATIONS

ABUT Abutment Iron Pipe or Pin Acre IRS Iron Rod Set AGG Agareaate JT Joint Ahead АН JCT Junction Angle LHF Left-Hand Forward ASPH Asphaltic Length of Curve AVG Average LIN FT Linear Foot Average Daily Traffic ADT or LF Long Chord of Curve LC MH RF Back Face Manhole BM Bench Mark Mailbox МВ Bridge ML or M/L Match Line B.A.D. Base Aggregate Dense North N NC CL or C/L CC Center Line Normal Crown Center to Center North Grid Coordinate CTH County Trunk Highway ΝB Northhound Outside Diameter OD PLE CR Crushed Permanent Limited CY or CU YD Cubic Yard Culvert Pipe Fasement РΤ Point of Curvature PC Curb and Gutter Point of Intersection PI PRC Degree of Curve Point of Reverse Curvature DHV Design Hour Volume DIA Diameter Point of Tangency East POC POT Point On Curve East Grid Coordinate Point on Tangent Eastbound PVC Polyvinyl Chloride ELEC Electric (al) PCC Portland Cement EL or ELEV ESALS Elevation` Concrete Pound Equivalent Single Axle LB Pounds Per Square Inch EBS Excavation Below PΕ Private Entrance Subgrade R RR Radius Face to Face Field Entrance Railroad RL or R/L Reference Line Finished Grade RP Reference Point FL or F/L Flow Line **RCCP** Reinforced Concrete Culvert Pipe Footing Grid North REOD Required Height Residence or Residential RES CWT Hundredweight RW Retaining Wall HYD Hydrant RT Right

RHF

RD

R/W

GENERAL NOTES

THE EXACT LOCATION AND WIDTH OF PRIVATE, COMMERCIAL, AND FIELD ENTRANCES TO BE DETERMINED BY THE ENGINEER IN THE FIELD.

ACCESS TO ALL ENTRANCES SHALL BE MAINTAINED DURING CONSTRUCTION.

WHEN THE QUANTITY OF THE ITEM OF BASE AGGREGATE OR HMA PAVEMENT IS MEASURED FOR PAYMENT BY THE TON, THE DEPTH OR THICKNESS OF THE LAYER SHOWN ON THE PLANS IS APPROXIMATE, AND THE ACTUAL THICKNESS WILL DEPEND ON THE DISTRIBUTION OF THE MATERIAL AS DIRECTED BY THE ENGINEER IN THE FIELD.

ELEVATIONS SHOWN ON THE PLAN ARE REFERENCED TO THE NORTH AMERICAN VERTICAL DATUM OF 1988 (NAVD 88).

CURVE DATA IS BASED ON THE ARC DEFINITION.

NO TREES OR SHRUBS ARE TO BE REMOVED WITHOUT THE APPROVAL OF THE ENGINEER

ASPHALTIC WASTE MATERIAL RESULTING FROM VARIOUS OPERATIONS UNDER THIS CONTRACT SHALL BE ENTIRELY REMOVED AND PROPERLY DISPOSED OF AT TIME OF OCCURRENCE.

UNLESS OTHERWISE SHOWN, ALL INTERSECTIONS SHALL BE TYPE "C"

THE EXACT LOCATION OF BUTT JOINTS AND AMOUNT OF ASPHALTIC SURFACE TO BE REMOVED AT THE SIDE ROADS WILL BE DETERMINED IN THE FIELD BY THE ENGINEER.

THE EXACT LOCATIONS OF EXISTING UTILITY INSTALLATIONS AS SHOWN ON THE PLAN ARE APPROXIMATE. THERE MAY BE OF UTILITY INSTALLATIONS WITHIN THE PROJECT AREA THAT ARE NOT SHOWN. THE CONTRACTOR SHALL COORDINATE HIS CONSTRUCTION ACTIVITIES WITH A CALL TO DIGGERS HOTLINE AND/OR A DIRECT CALL TO THE UTILITIES THAT HAVE FACILITIES IN THE AREA.

ASPHALTIC HMA PAVEMENT SHALL BE CONSTRUCTED WITH THE FOLLOWING LAYER THICKNESS:

PAVEMENT	LOWER	NOM AGG	UPPER	NOM AGG
THICKNESS	LAYER	SIZE	LAYER	SIZE
(INCH)	(INCH)	(MM)	(INCH)	(MM)
4	2.25	19	1.75	12.5

Dial or (800) 242-8511

* DENOTES UTILITY IS NOT A MEMBER OF DIGGERS HOTLINE

BORING LOG

Roadway

Salvaged

Section

Shoulder

Sidewalk

South

SF or SQ FT Square Feet

SY or SQ YD Square Yard

Shrinkage

Southbound

Standard

Station

Storm Sewer

Superelevation

Survey Line

Septic Vent

Tanaent

Telephone

Temporary

Top Of Curb

Transit Line

Unclassified

Vertical Curve

Transition

Typical

Variable

Vertical

Volume

West

Yard

Water Main

Water Valve

Westbound

Town

Temporary Interest

Temporary Limited Easement

Trucks (percent of)

Underground Cable

United States Highway

Velocity or Design Speed

Subarade

Standard Detail Drawings

State Trunk Highways

Sanitary Sewer

SAN S SEC

SHLDR

SHR

STD

SDD

STH

STA

SS

SG

SV

TEMP

TLE

TC:

TYP UNCL

UG

USH

VAR

VERT

VC

VOL

WM

WV

Right-Hand Forward

Right-of-Way

River

Road

T or TN

TL or T/L

TRANS

SL or S/L

SW

CORE NO.	STATION	CL OFFSET	ASPHALT DEPTH	BASE COURSE	SUBBASE
F-9	111+88	6' RT.	2.25"	4" GRAVEL WITH SAND	17.75" GRAVELLY SAND
F-10	132+10	8' LT.	3"	4" GRAVEL WITH SAND	17" GRAVELLY SAND
F-11	152+27	7' RT.	3"	5" GRAVEL WITH SAND	16" GRAVELLY SAND
F-12	174+61	5' LT.	2.75"	5" GRAVEL WITH SAND	28.25" GRAVELLY SAND
F-13	196+73	5' RT.	3.25"	5" GRAVEL WITH SAND	10.75" GRAVELLY SAND
F-14	218+27	6' LT.	2"	4" GRAVELLY SAND	20" GRAVEL WITH SAND
F-15	242+72	9' RT.	2"	4" GRAVELLY SAND	10" GRAVELLY SAND
F-16	238+20	10' LT.	3"	4" GRAVEL WITH SAND	8" GRAVELLY SAND
F-17	233+69	7' RT.	2.5"	4" GRAVEL WITH SAND	12.5" GRAVEL WITH SAND

		HIDROLOGIC SOIL GROUP										
		1	4		E	3	С		D			
	SLOPE RANGE (PERCENT)		SLOPE RANGE (PERCENT)		SLOPE RANGE (PERCENT)		SLOPE RANGE (PERCENT)					
LAND USE	0-2	2-6	6 & OVER	0-2	2-6	6 & OVER	0-2	2-6	6 & OVER	0-2	2-6	6 & OVER
ROW CROPS	.08 .22	.16 .30	.22 .38	.12 .26	.20 .34	.27 .44	.15 .30	.24 .37	.33 .50	.19 .34	.28 .41	.38 .56
MEDIAN STRIP-TURF	.19 .24	.20 .26	.24 .30	.19 .25	.22 .28	.26 .33	.20 .26	.23 .30	.30 .37	.20 .27	.25 .32	.30 .40
SIDE SLOPE- TURF			.25 .32			.27 .34			.28 .36			.30 .38
PAVEMENT												
ASPHALT						.70 -	95					
CONCRETE						.80 -	95					
BRICK				.70 -	.70 — .80							
DRIVES, WALKS	DRIVES, WALKS .7585											
ROOFS							95					
GRAVEL ROADS	S, SH	OULDE	RS			.40 -	60					

HYDROLOGIC SOIL GROUP


TOTAL PROJECT AREA= 41.36 ACRES TOTAL AREA EXPECTED TO BE DISTURBED BY CONSTRUCTION ACTIVITIES = 16.31 ACRES

PROJECT NO: 9478-05-70 HWY: CTH F COUNTY: MARATHON

GENERAL NOTES, UTILITIES, CONTACTS & ABBREVIATIONS


SHEET 2

Ε

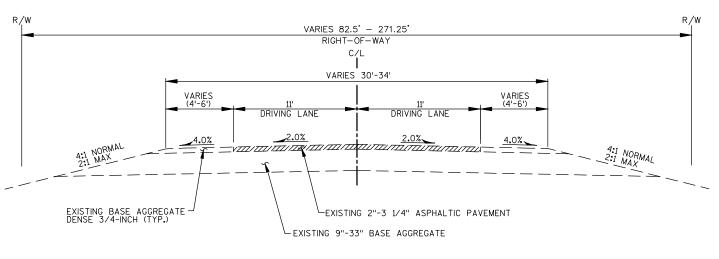

TYPICAL EXISTING SECTION

CTH F STA. 100+75.00 - STA. 301+55.00

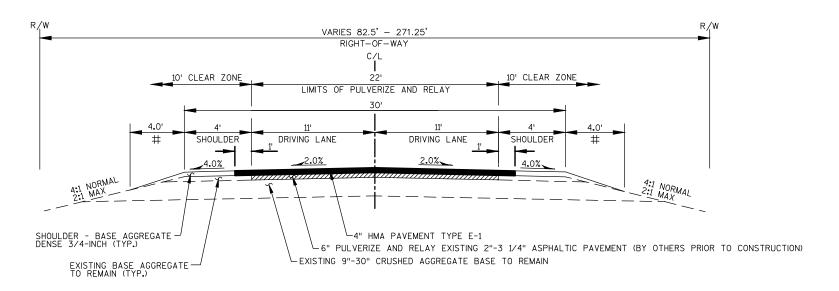

TYPICAL FINISHED SECTION

CTH F

STA. 100+75.00 - STA. 143+14.00 STA. 150+00.79 - STA. 158+73.35 STA. 162+92.01 - STA. 175+70.00 STA. 178+70.00 - STA. 249+01.00 STA. 252+00.00 - STA. 301+55.00

LIMITS OF FERTILIZER TYPE B, SEEDING MIXTURE NO. 20, SEEDING TEMPORARY & MULCH

DRIVING LANE SHOULDER SHOULDER - BASE AGGREGATE DENSE 3/4-INCH (TYP.) 4" HMA PAVEMENT TYPE E-1 -6" PULVERIZE AND RELAY EXISTING 2"-3 1/4" ASPHALTIC PAVEMENT (BY OTHERS PRIOR TO CONSTRUCTION) EXISTING 9"-30" CRUSHED AGGREGATE BASE TO REMAIN

TYPICAL FINISHED HALF SECTION AT BEAM GUARD

CTH F

STA. 159+45 - STA. 172+20, RT. STA. 221+15 - STA. 224+40, RT.

 \pm NOTE: WHEN DISTANCE FROM BACK OF POST TO SHOULDER HINGE POINT IS LESS THAN 2 FEET INSTALL MGS GUARDRAIL 3 K


PROJECT NO: 9478-05-70 HWY: CTH F COUNTY: MARATHON TYPICAL SECTIONS

FILE NAME: R:\PROJECTS\M97010 CTH F MARATHON COUNTY\CADD FILES\PRODUCTION DRAWINGS\ROADWAY\2 - TYPICAL SECTIONS & DETAILS\3-TYPICAL SECTIONS\M97010 TYPICAL SECTIONS.DWG

PLOT BY: ECKELBERG, PATRICKPLOT DATE: 11/18/2013 5:20 PM

SHEET 3

Ε

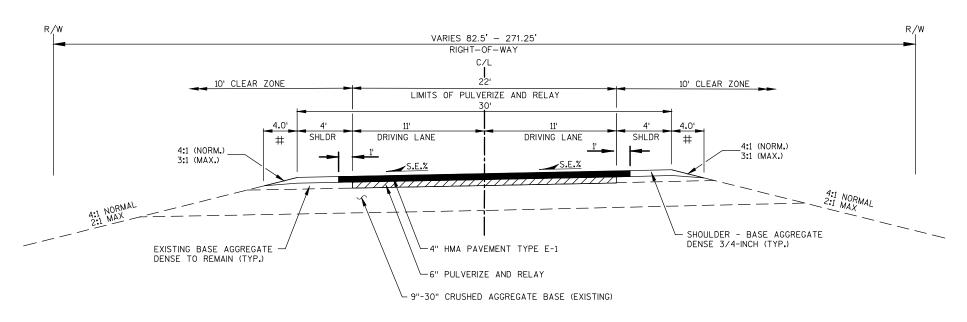

TYPICAL FINISHED SUPERELEVATED SECTION

TYPICAL SECTIONS

CTH F STA. 147+59.00 - STA. 158+00.79 STA. 158+73.35 - STA. 162+92.61

 \sharp LIMITS OF FERTILIZER TYPE B, SEEDING MIXTURE NO. 20, SEEDING TEMPORARY & MULCH

NOTE:THE LOW SIDE SHOULDER SLOPE ON SUPERELEVATED SECTIONS EQUALS THE SUPERELEVATION WHEN THE SUPERELEVATION IS GREATER THAN 0.04 FT./FT. IF THE SUPERLEVATION IS LESS THAN OR EQUALS 0.04 FT./FT., THEN THE LOW SIDE SHOULDER SLOPE IS 0.04 FT./FT. THE HIGH SIDE SHOULDER SLOPE ON THE SUPERELEVATED SECTION EQUALS THE SUPERELEVATION.

PROJECT NO: 9478-05-70

SUPERELEVATION DATA TABLE

	EXISTING SUPERELVATION RATE (%)		PROPOSED SUPERE	LVATION RATE (%)	CHANGE IN SUPERELVATION	
PI STATION	LEFT	RIGHT	LEFT	RIGHT	LEFT	RIGHT
152+83.08	6.80	12.80	8.00	8.00	1.20	-4.80
160+83.02	2.60	6.50	6.00	6.00	3.40	-0.50
180+59.66	3.00	1.70	N.C.	N.C.	-1.00	0.30
203+19.44	1.50	4.00	N.C.	N.C.	0.50	-2.00
227+96.81	N.C.	N.C.	N.C.	N.C.	-	-


COUNTY: MARATHON

FILE NAME: R:\PROJECTS\M97010 CTH F MARATHON COUNTY\CADD FILES\PRODUCTION DRAWINGS\ROADWAY\2 - TYPICAL SECTIONS & DETAILS\3-TYPICAL SECTIONS\M97010 TYPICAL SECTIONS.DWG

HWY: CTH F

SHEET 4

Ε

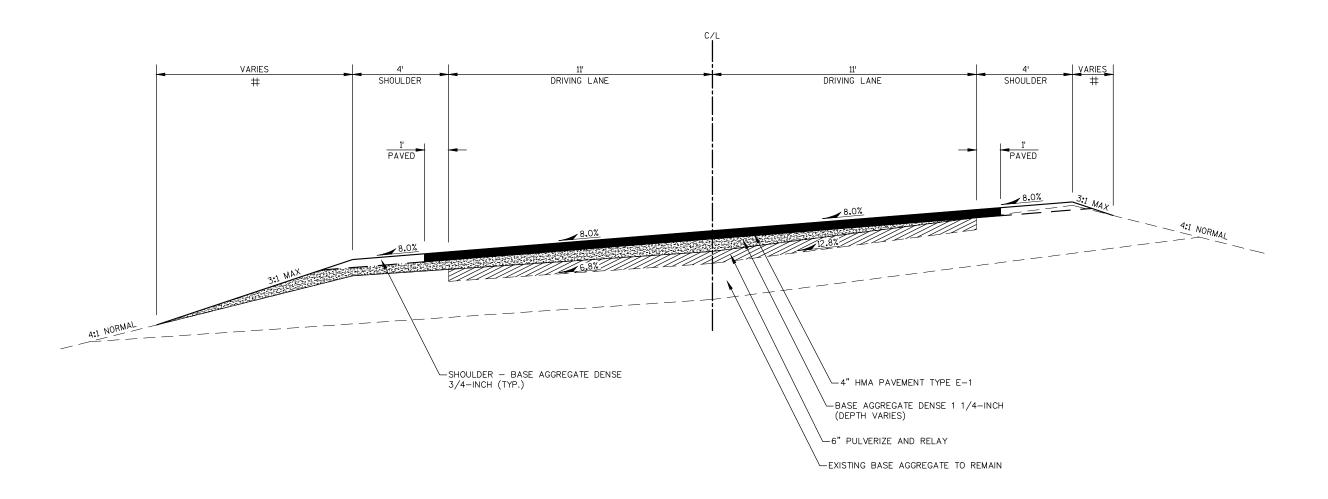


SUPERELEVATION CORRECTION DETAILS

CTH F

STA. 147+59.00 - STA. 158+00.79 STA. 158+73.35 - STA. 162+92.61 STA. 178+70.00 - STA. 183+22.99 STA. 200+21.99 - STA. 206+16.22

NOTE: DETAIL ABOVE SHOWS CORRECTION OF SUPERELEVATION IN CURVE 1 FROM AN EXISTING SUPERELEVATION OF 6.8% LEFT AND 12.8% RIGHT TO A PROPOSED SUPERELEVATION OF 8.0%.


LIMITS OF FERTILIZER TYPE B, SEEDING MIXTURE NO. 20, SEEDING TEMPORARY & MULCH

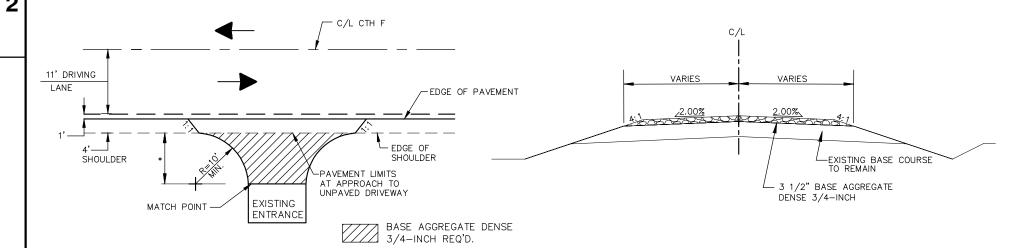

TYPICAL CROSS SECTION FOR PRIVATE DRIVE AND FIELD ENTRANCE

			PAVEMENT	WIDTH	
STATION	LOCATION	TYPE	EXISTING	PROPOSED	(ft)
102+69	MAINLINE, RT.	P.E.	BASE AGGREGATE DENSE	BASE AGGREGATE DENSE	11
1 1 0+39	MAINLINE, LT.	P.E.	BASE AGGREGATE DENSE	BASE AGGREGATE DENSE	13
122+75	MAINLINE, LT.	F.E.	BASE AGGREGATE DENSE	BASE AGGREGATE DENSE	15
126+62	MAINLINE, LT.	F.E.	BASE AGGREGATE DENSE	BASE AGGREGATE DENSE	25
128+22	MAINLINE, LT.	P.E.	BASE AGGREGATE DENSE	BASE AGGREGATE DENSE	18
131+54	MAINLINE, LT.	F.E.	BASE AGGREGATE DENSE	BASE AGGREGATE DENSE	18
139+38	MAINLINE, LT.	*	BASE AGGREGATE DENSE	BASE AGGREGATE DENSE	21
139+25	MAINLINE, RT.	•	BASE AGGREGATE DENSE	BASE AGGREGATE DENSE	13
160+08	MAINLINE, LT.	F.E.	BASE AGGREGATE DENSE	BASE AGGREGATE DENSE	11
180+68	MAINLINE, RT.	••	BASE AGGREGATE DENSE	BASE AGGREGATE DENSE	21
187+80	MAINLINE, LT.	F.E.	BASE AGGREGATE DENSE	BASE AGGREGATE DENSE	15
190+57	MAINLINE, RT.	F.E.	BASE AGGREGATE DENSE	BASE AGGREGATE DENSE	13
209+48	MAINLINE, RT.	F.E.	BASE AGGREGATE DENSE	BASE AGGREGATE DENSE	13
209+57	MAINLINE, LT.	P.E.	BASE AGGREGATE DENSE	BASE AGGREGATE DENSE	14
222+10	MAINLINE, LT.	F.E.	BASE AGGREGATE DENSE	BASE AGGREGATE DENSE	10
225+50	MAINLINE, RT.	F.E.	BASE AGGREGATE DENSE	BASE AGGREGATE DENSE	15
231+08	MAINLINE, LT.	F.E.	BASE AGGREGATE DENSE	BASE AGGREGATE DENSE	13
236+47	MAINLINE, RT.	P.E.	BASE AGGREGATE DENSE	BASE AGGREGATE DENSE	11
237+85	MAINLINE, RT.	P.E.	BASE AGGREGATE DENSE	BASE AGGREGATE DENSE	13
242+18	MAINLINE, LT.	F.E.	BASE AGGREGATE DENSE	BASE AGGREGATE DENSE	14
242+33	MAINLINE, RT.	F.E.	BASE AGGREGATE DENSE	BASE AGGREGATE DENSE	16

- * CORRIDOR 18 SNOWMOBILE/ATV TRAIL X-ING
- ** AMCO COUNTY PARK ENTRANCE

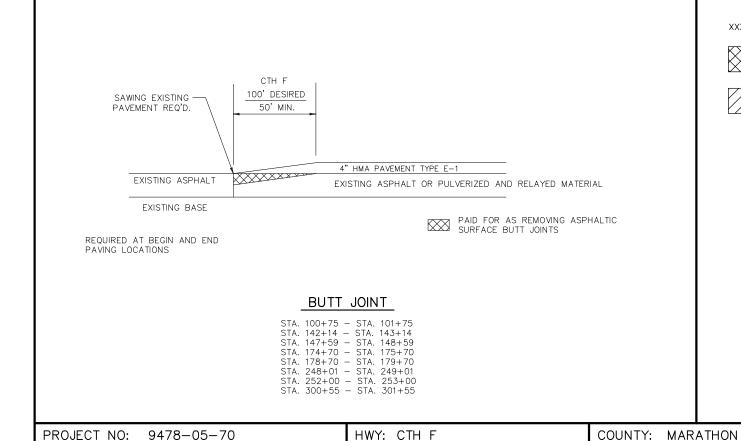

TYPICAL PRIVATE AND

FIELD ENTRANCE DETAILS

* 10' MIN. OR LIMITS AS DIRECTED BY ENGINEER

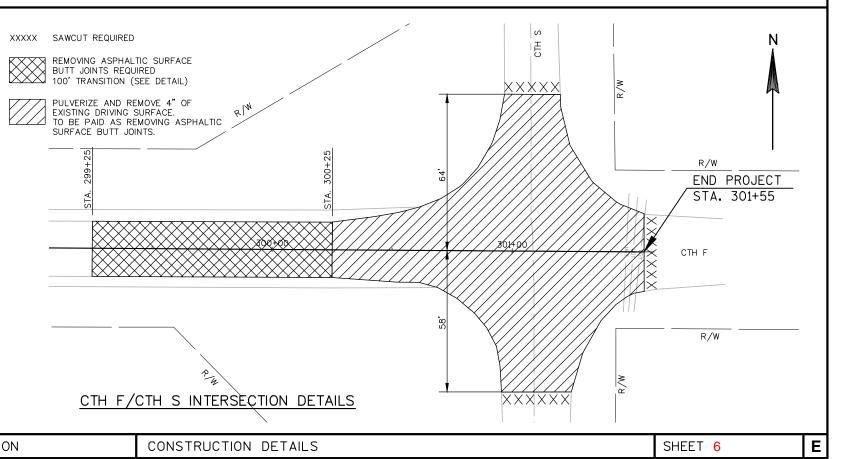


* REMOVING ASPHALTIC SURFACE BUTT JOINTS LIMITS TO BE DETERMINED BY ENGINEER IN FIELD.



SIDEROAD DETAIL

NOTE: GRADING, SHAPING, AND FINISHING SIDEROADS IS CONSIDERED INCIDENTAL TO HMA PAVEMENT TYPE E-1

¬ HMA PAVEMENT TYPE E−1

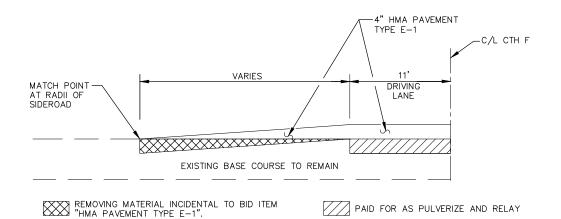


DETAILS OF BASE AGGREGATE DENSE AT SIDE ROADS


SIDE ROAD DATA TABLE

	PAVEMENT STRU	JCTURE	W
SIDEROAD	EXISTING	PROPOSED	(ft.)
* MERIDIAN RD.	ASPHALT	ASPHALT	24
DIETSCH RD. (NORTH)	BASE AGGREGATE DENSE	ASPHALT	24
DIETSCH RD. (SOUTH)	BASE AGGREGATE DENSE	ASPHALT	19
FELLBAUM RD.	BASE AGGREGATE DENSE	ASPHALT	25
13TH LN.	BASE AGGREGATE DENSE	ASPHALT	24
CTH S (NORTH)	ASPHALT	ASPHALT	23
CTH S (SOUTH)	ASPHALT	ASPHALT	29

^{*} DENOTES BASE AGGREGATE DENSE SIDEROAD PREVIOUSLY PAVED TO RADII POINTS AT INTERSECTION

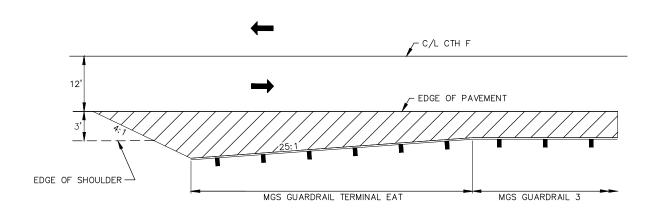

DETAIL FOR ASPHALTIC SHOULDER AT STEEL PLATE BEAM GUARD

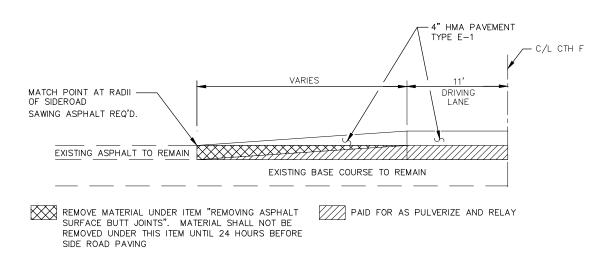

DETAILS OF HMA PAVEMENT AT SIDE ROADS

PROJECT NO: 9478-05-70 HWY: CTH F COUNTY: MARATHON CONSTRUCTION DETAILS SHEET 7 ____ **E**

CENTER OF SECTION CORNER (PLAN VIEW OF DRILL HOLE)


-APPROX. D=0.50"

-CENTER OF SECTION CORNER (TO BE MARKED WITH

A PUNCH MARK)

A PUNCH MARK)

(1) MARATHON COUNTY MONUMENT MARKER LOGO

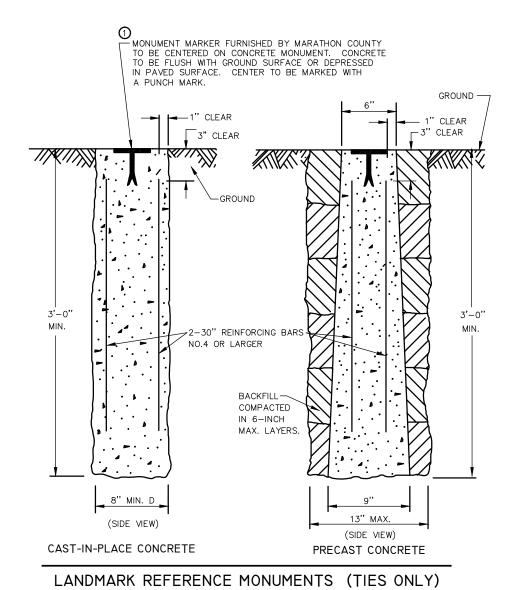

SECTION CORNER MONUMENTS

(SIDE VIEW)

1 BERNSTEN SNMI STEEL NAIL MARKER

IN ASPHALTIC PAVEMENT

CENTER OF SECTION CORNER (PLAN VIEW)

-APPROX. D=0.50"

APPROX.

-CENTER OF SECTION CORNER

SET TOP OF BRASS MARKER 1/16"-

CONCRETE

PAVEMENT

NOTE: TO DRILL HOLE, USE A "SURVEY MARKER COUNTERSINK DRILL BIT"

ITEM #BPMDRL, AVAILABLE FROM BERNTSEN INTERNATIONAL INC.

1 BERNSTEN BP -I BRASS MARKER WITH ANCHOR PLUG

(SIDE VIEW OF DRILL HOLE) IN CONCRETE PAVEMENT

BELOW CONCRETE SURFACE

GENERAL NOTES

DETAILS OF CONSTRUCTION, MATERIALS AND WORKMANSHIP NOT SHOWN ON THIS DRAWING SHALL CONFORM TO THE PERTINENT REQUIREMENTS OF THE STANDARD SPECIFICATIONS AND THE APPLICABLE SPECIAL PROVISIONS.

LOCATE LANDMARK REFERENCE MONUMENTS OUTSIDE THE CONSTRUCTION LIMITS AND WITHIN MARATHON COUNTY RIGHT OF WAY. LOCATION TO BE APPROVED BY THE ENGINEER.

1 MARATHON COUNTY WILL SUPPLY.

SECTION CORNER MONUMENT AND LANDMARK REFERENCE MONUMENT DETAIL

-SECTION CORNER LOCATION TO BE MARKED WITH A PUNCH MARK

- GROUND

2'-6"

-BREAK-OFF

MIN.

OUTSIDE OF PAVEMENT

(SIDE VIEW)

1 BERNSTEN AIBR30 ALUMINUM BREAK-OFF MONUMENT

DRIVE TOP OF STEEL NAIL MARKER FLUSH WITH

ASPHALT

PAVEMENT

TOP OF —— AGGREGATE SHOULDER

BACKFILL COMPACTED

IN 6-INCH MAX. LAYERS.

HWY: CTH F CONSTRUCTION DETAILS PROJECT NO: 9478-05-70 COUNTY: MARATHON


> PLOT DATE: 3/15/11 PLOT BY: JRG PLOT NAME :


FILE NAME: R:\PROJECTS\M97010 CTH F Marathon County\CADD FILES\Production Drawing\Roadway\MONUMENT DETAIL.DWG

PLOT SCALE : 1=1

WISDOT/CADDS SHEET 42

SHEET 8

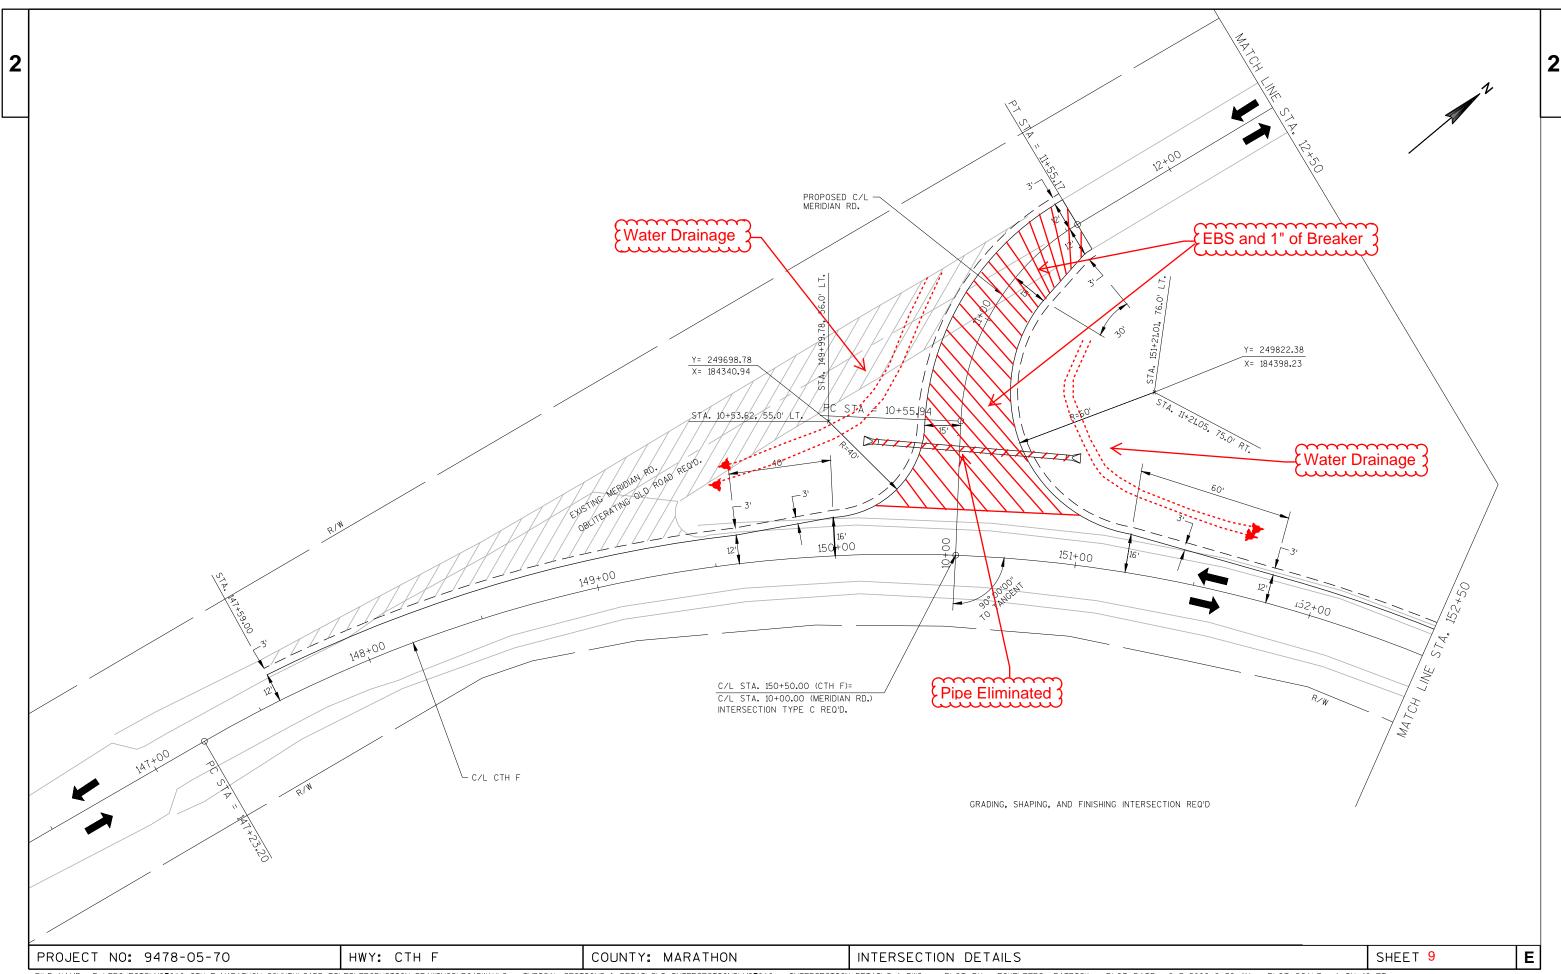

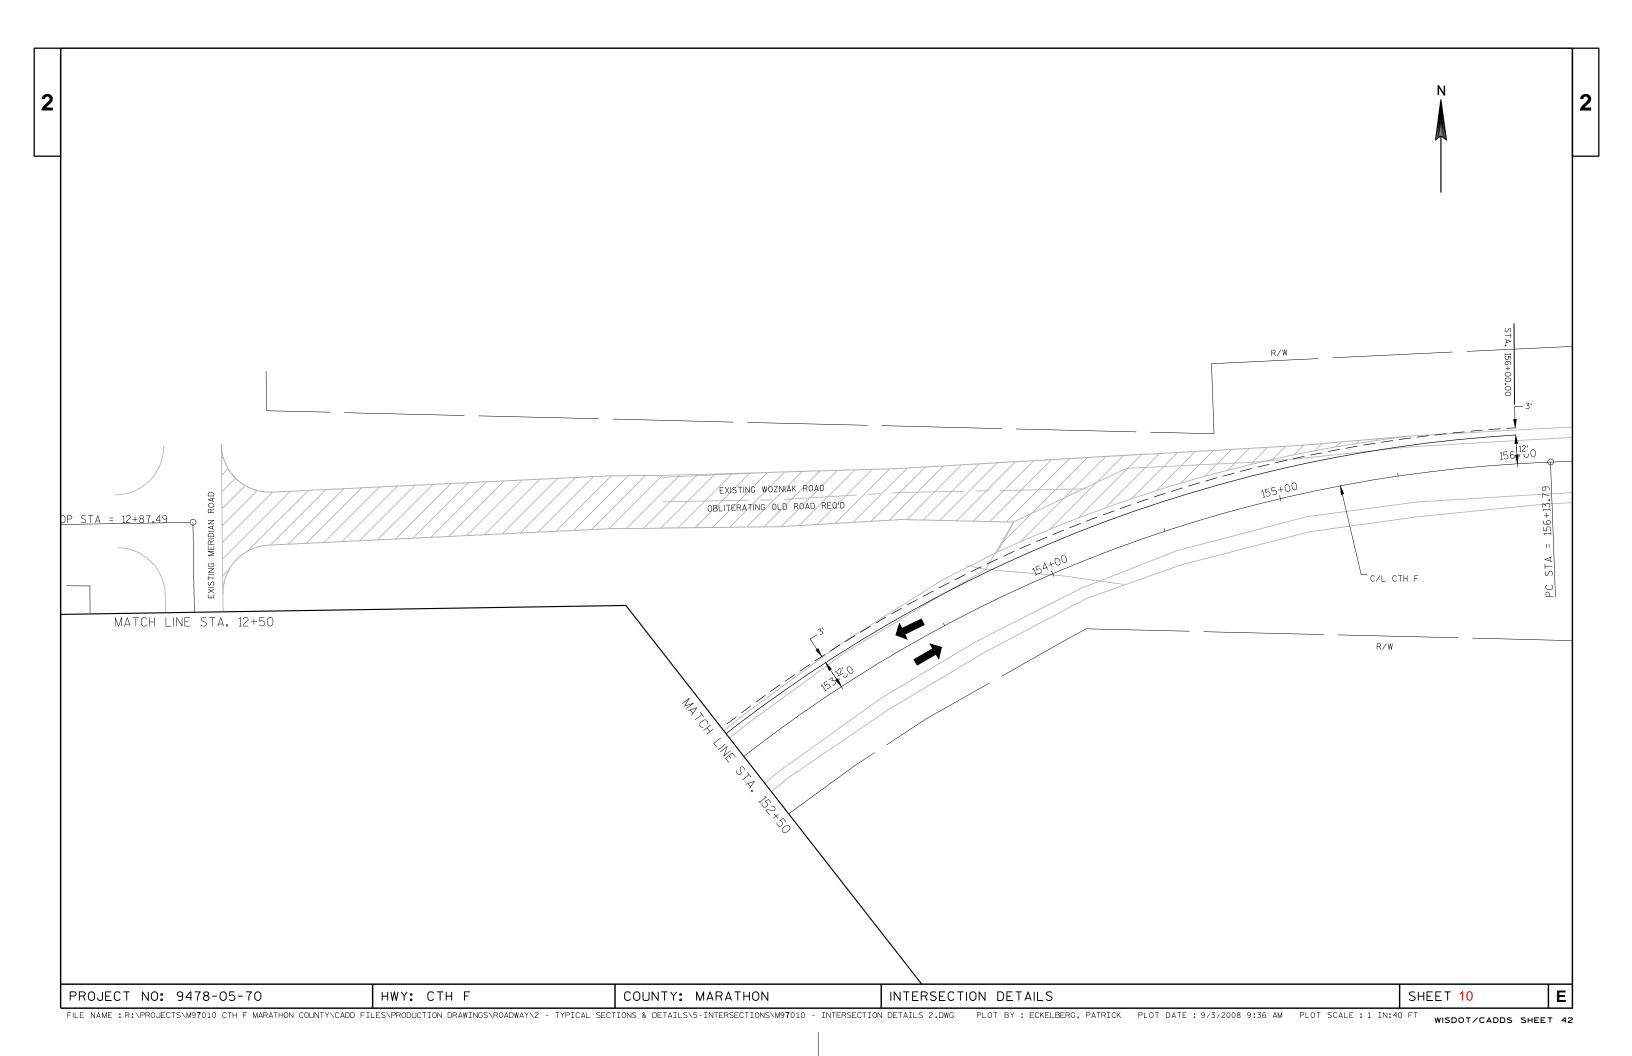

Ε

SHEET 11

GRADING, SHAPING AND FINISHING INTERSECTION

				FOR INFORMATION ONLY					
			205.9015.S.01 GRADING, SHAPING	205.0100	625.0100	627.0200	629.0210	630.0120 SEEDING	630.0200
			ANO FINISHING INTERSECTION	EXCAVATION COMMON	TOPSOIL	MULCHING	FERTILIZER TYPE B	MIXTURE NO. 20	SEEDING TEMPORARY
PROJECT IO	STATION - STATION	LOCATION	(LS)	(CY)	(\$Y)	(\$Y)	(CWT)	(LB)	(LB)
9478-05-70	100+75 - 301+55	MERIDIAN RD	1	200	350	350	0.25	9.5	4.75
		TOTAL =	1	200	350	350	0.25	9.5	4.75

PREPARE FOUNDATION FOR ASPHALTIC PAVING

PROJECT ID 9478-05-70	STATION - STATION 100+75 - 301+55	LOCATION MAINLINE	211.0100 (LS) 1
		TOTAL -	

FINISHING ROADWAY

PROJ	ECT ID	STATION - STATION	LOCATION	213.0100 (EACH)
9478	05-70	100+75 - 301+55	MAINLINE	1
			TOTAL =	1

OBLITERATING OLD ROAD

				FOR INFORMATION ONLY					
			214.0100	205.0100	625.0100	627.0200	629.0210	630.0120 SEEDING	630.0200
			OBLITERATING	EXCAVATION			FERTILIZER	MIXTURE	SEEDING
			OLD ROAD	COMMON	TOPSOIL	MULCHING	TYPE B	NO. 20	TEMPORARY
PROJECTIO	STATION - STATION	LOCATION	(STA)	(CY)	(\$Y)	(\$Y)	(CWT)	(LB)	(LB)
9478-05-70	151+67 - 154+25	OTH F (MAINLINE), LT	4	700	1050	1050	0.66	28	14
	149+00 - 150+50	OTH F (MAINLINE), LT	2	300	400	400	0.34	12	6
				4000	4.50	4.50			
		TOTAL =	6	1000	1450	1450	1	40	20

ASPHALTIC ITEMS

PROJECT ID	STATION - STATION	LOCATION	455.0105 ASPHALTIC MATERIAL PG 58-28 (TON)	455.0605 TACK COAT (GAL)	460.1101 HMA PAVEMENT TYPE E-1 (TON)
9478-05-70	100+75 - 143+14	MAINLINE	143	283	2600
	147+59 - 175+70	MAINLINE	95	187	1724
	178+70 - 249+01	MAINLINE	237	469	4312
	252+00 - 301+55	MAINLINE	167	330	3039
	159+45 - 172+20	MAINLINE, RT	6	11	104
	221+15 - 224+40	MAINLINE, RT	2	3	31
	-	MERIDIAN ROAD	8	15	137
	-	DIETSCH ROAD (NORTH)	1	2	15
	-	DIETSCH ROAD (SOUTH)	2	4	40
	-	FELBAUM ROAD	3	5	48
	_	13TH LANE	1	3	26
	-	CTH \$ (NORTH)	3	7	63
	-	CTH S (SOUTH)	3	6	52
	-	UNDISTRIBUTEO	24	35	359
		TOTAL =	695	1360	12550

NOTE: ASPHALTIC CONTENT IS 5.5%

HMA PAVEMENT 115 LBS/(SQUARE YARD * INCH OF THICKNESS)


TACK COAT 0.025 GAL/SY

PROJ ID	DESC	ITEM#	<u>STA</u>	LOC	QUANTITY	<u>′</u>
9478-05-70	BREAKER RUN	311.0110	10+00 TO 11+55	MERIDIAN RD	600 TON	CCO#1
9478-05-70	PIPE EXTENSION					
	& GRADING	SPV.0105	223+00 RT	MAINLINE	1 LS	CCO #2

BASE AGGREGATE DENSE

			305.0110	305.0120
			3/4-INCH	1 1/4-INCH
PROJECTIO	STATION - STATION	LOCATION	(TON)	(TON)
9478-05-70	100+75 - 143+14	MAINLINE	1101	_
	147+59 - 175+70	MAINLINE	715	-
	178+70 - 246+01	MAINLINE	1812	_
	252+00 - 301+55	MAINLINE	1256	-
	100-75 - 301+55	P.E. & F.E.	158	-
	159+45 - 172+20	MAINLINE, RT	737	_
	221+15 - 224+40	MAINLINE, RT	188	-
	10+00 - 11+55	MERIDIAN ROAD	28	270
	-	DIETSCH (NORTH)	8	-
	-	DIETSCH (SOUTH)	8	-
	_	FELBAUM ROAD	13	_
	-	13TH LANE	8	-
		CTH'S (NORTH)	16	-
	-	CTH S (SOUTH)	16	-
	-	UNDISTRIBUTED	186	10
		TOTALS =	6250	280

CULVERT PIPE

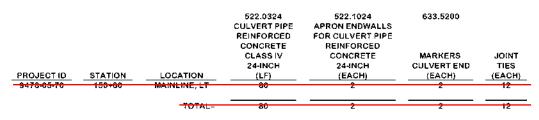

ALL NEW CONCRETE CULVERT PIPE SHALL HAVE JOINT TIES ON THE LAST TWO PIPE-TO-PIPE JOINTS AND AT THE PIPE-TO-ENDWALL JOINT AT BOTH THE INLET AND DISCHARGE ENDS. JOINT TIES ARE A NON-BID ITEM; THE COST SHALL BE INCLUDED IN THE PRICE PER LINEAR FOOT OF PIPE.

PROJECT NO: 9478-05-70


HWY: CTH F


COUNTY: MARATHON


MISCELLANEOUS QUANTITIES


PLOT DATE: 11/18/2013


3	9478-05-70		В	614.0010 ARREIR SYSTEM RADING SHAPING FINISHING (EACH) 1 2	208.0100	OF SHAPING FI 627.026 TOPSOIL (SY) (SY) 3320 4050 966 1176 4280 5220	FOR IN 0 629 FER1 NG TY	IFORMATION ONLY	650.0200 CONSTRUCTIO STAKING SUBGRADE (LF) 1325 375	650.9920 N CONSTRUCTION STAKING SLOPE STAKES (LF) 1325 375	PROJECT ID STATION STATION LOCATION TRAFFIC CONTROL (EACH) TOTALS = 1
	9478-05-70	TATION - STATION	GUARDRAIL MG LOCATION MAINLINE, RT MAINLINE, RT TOTALS =	614.2300 65 GUARDRAIL 3 (LF) 1175 225 1400	614.2610 MGS GUARDRAIL TERMINAL EAT (EACH) 2 2	PROJECT IO 9478-05-70 NOTE	100 10	WATER ION - STATION +75 - 301+55 +55 - 11+55 ON BASE AGGREGATE DE	LOCATION MAINLINE MERIDIAN RD UNDISTRIBUTED	624.0100 (MGAL) 66 3 6	PROJECT ID STATION LOCATION (LF) (
		<u>'ATION - STATION</u> 100+75 - 301+55	FINISHIN LOCATION MAINLINE LT. & RT. UNDISTRBUTED	627.0200 MULCHING (SY) 17340 1660	629.0210 FERTILIZER TYPE B (CWT) 11 3	630.0120 630.00 SEEDING MIXTURE SEEDINO.20 TEMPOI (LB) (LB 470 236	NG RARY	PROJECT ID 9478-05-70	MOBILIZATIO LOCATION MAINLINE TOTAL =	619.1000 (EACH) 1	PROJECT ID STATION - STATION LOCATION CEACH CULVERT CULVERT CULVERT CULVERT CULVERT CONTROL CEACH CLF) CLF CLF
	SEE	OING MIXTURE NO. 20 APPLI DING TEMPORARY APPLICA TILIZER APPLICATION RATE	TION RATE 1.5 LBS/1000		14	550 290		FIEL PROJECT IO 9478-05-70	D OFFICE TY LOCATION PROJECT TOTAL =	642.5001 (EACH) 1	SAWING ASPHALT 690.0150 69478-05-70 100+75 MAINLINE 22 143+14 MAINLINE 22 175+70 MAINLINE 22 178+70 MAINLINE 23 178+70 MAINLINE 24 178+70
	PROJECT ID 9478-05-70	<u>STATION - STATION</u> 147 +6 5 150+10	LOCATION MAINLINE, LT MAINLINE, LT	628.1504 SILT FENCE (LF)	EROSION C 628.1520 SILT FENCE MAINTENANCE (LF)	628.1905 MO MOBILIZATION EN EROSION (CONTROL (BILIZATION BILIZATION BERGENCY EROSION CONTROL (EACH)	628.2023 EROSION MAT CLASS II TYPE B (SY) 4	628.7504 TEMPORARY DITCH CHECKS (LF) 10	628.7555 CULVERT PIPE CHECKS (EACH)	249+01 MAINLINE 22 252+00 MAINLINE 22 301+55 MAINLINE 32 — CTH S (NORTH) 23 — CTH S (SOUTH) 30 — CTH F 32 TOTALS = 272 REESTABLISH SECTION CORNER MONUMENTS
		151+00 153+00 159+45 - 172+20 221+15 - 224+40 100+75 - 301+55	MAINLINE, LT MAINLINE, LT MAINLINE, RT MAINLINE, RT UNDISTRIBUTED TOTAL =	1325 375 400 2100	2650 750 800	- - - 2 - 2	1	6	10 - - 5 	6 - - - - - 6	PROJECT ID STATION LOCATION (EACH) 9478-05-70 126+39.77 MAINLINE, 0.18' RT 1 202+76.89 MAINLINE, 4.14' RT 1 228+90.85 MAINLINE, 0.18' RT 1 2255+16.62 MAINLINE, 1.63' LT 1 274+71.60 MAINLINE, 0.62' RT 1 301+08.61 MAINLINE, 0.65' RT 1 TOTAL= 6
ᆫ		9478-05-70 CTS\M97010 CTH F MARATHON C	HWY: CTH			JTY: MARATHO		MISCELLANEOL	JS QUANTITI	: 11/18/2013	PLOT BY: ECKELBERG, PATRICK

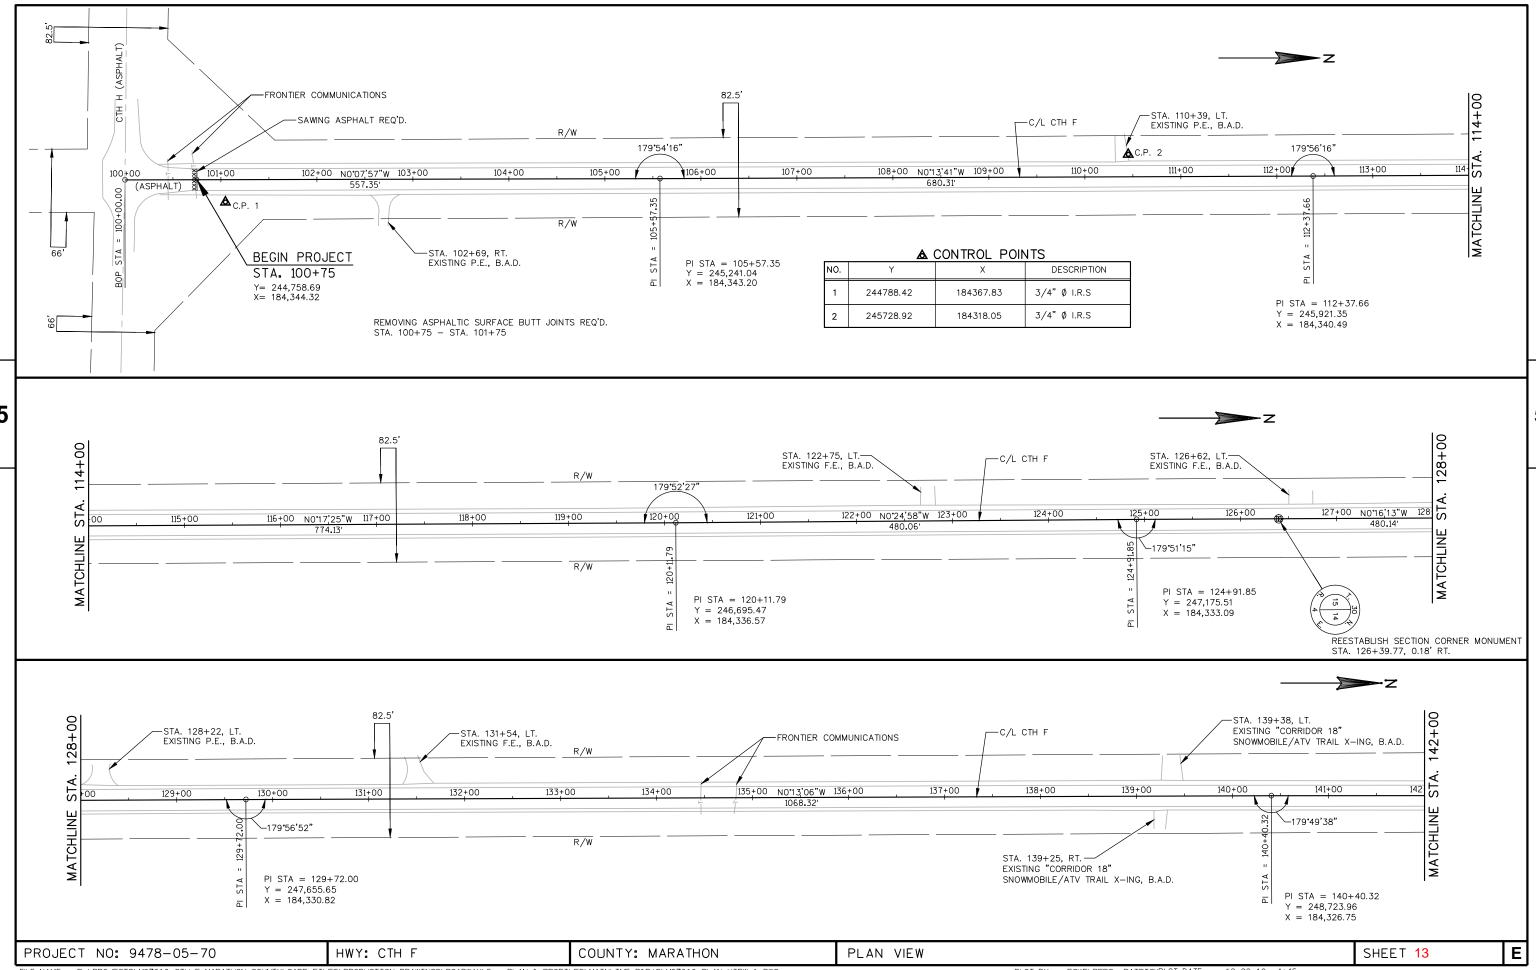

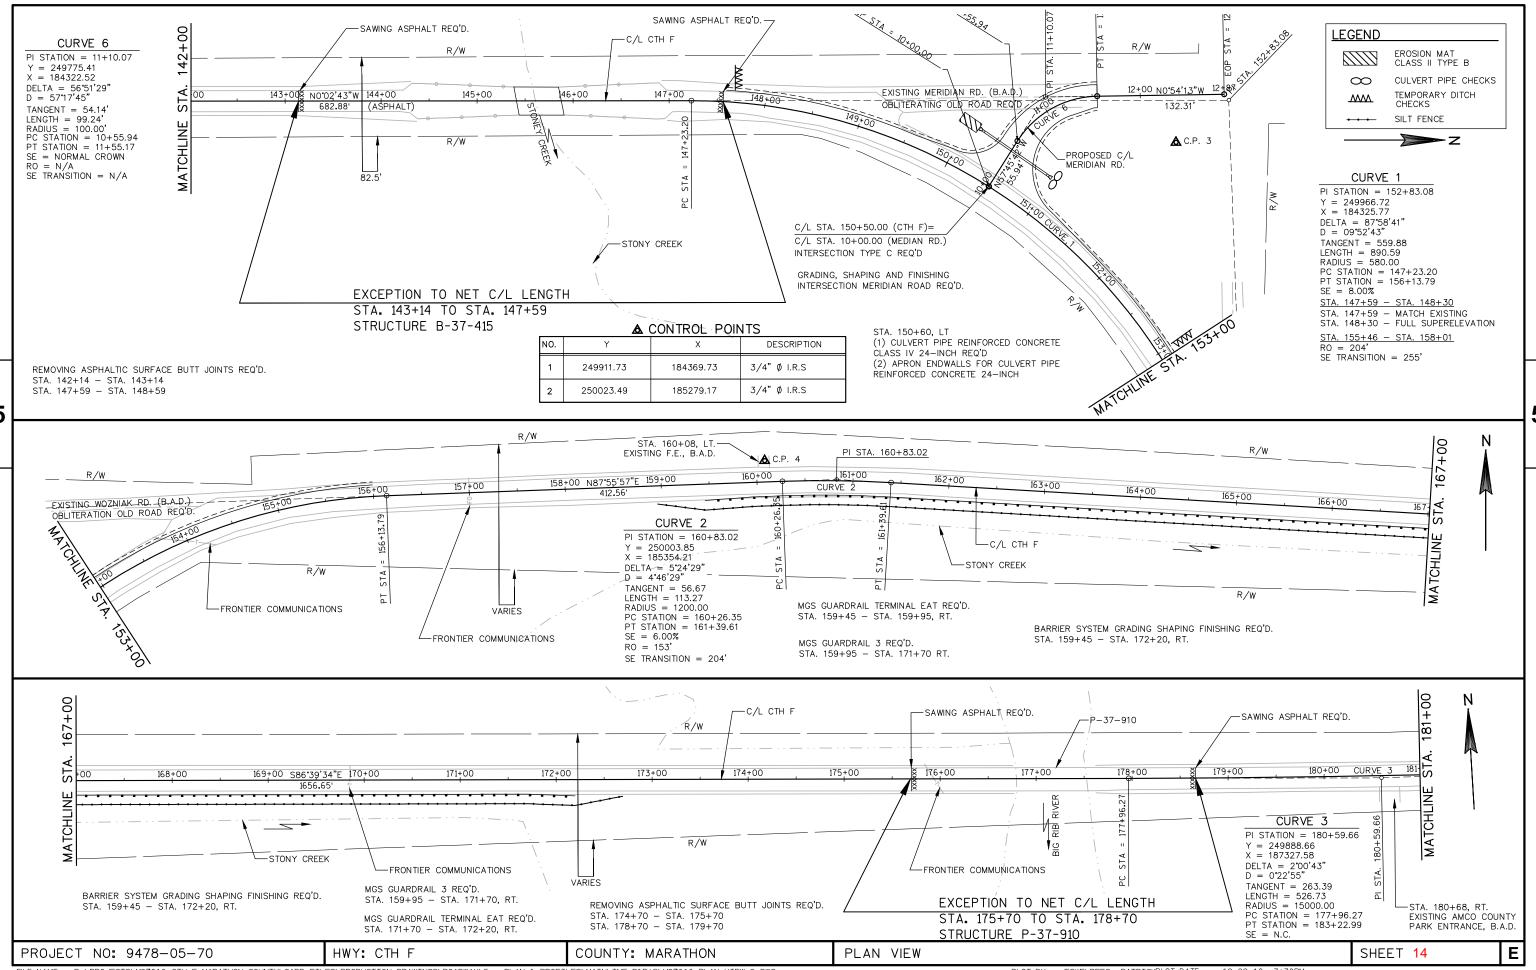

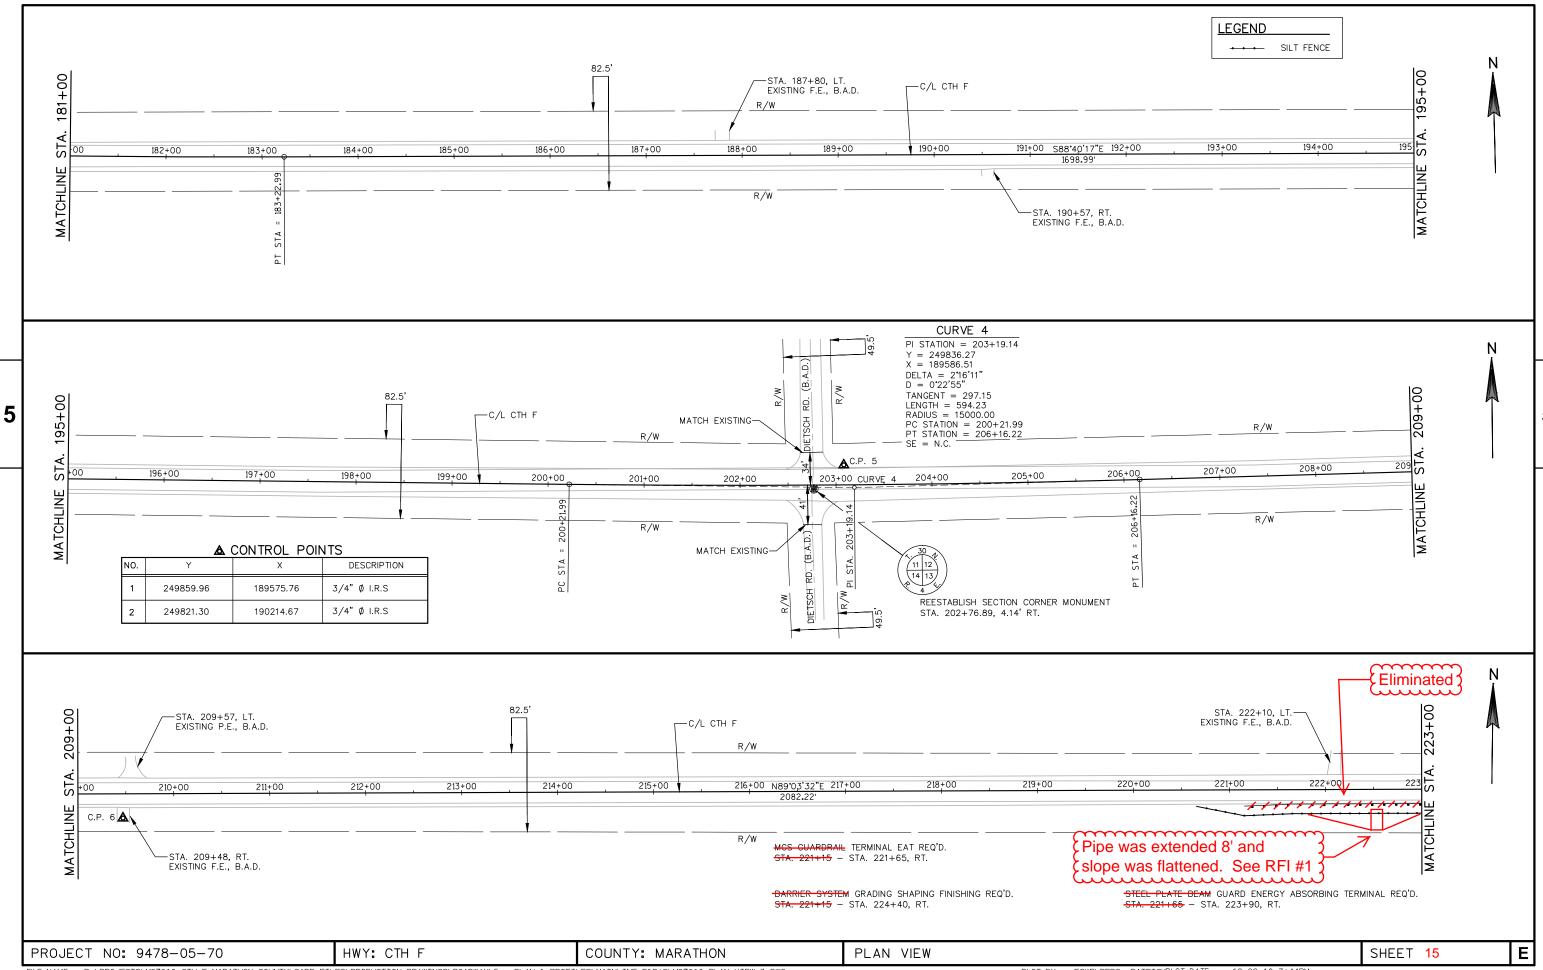


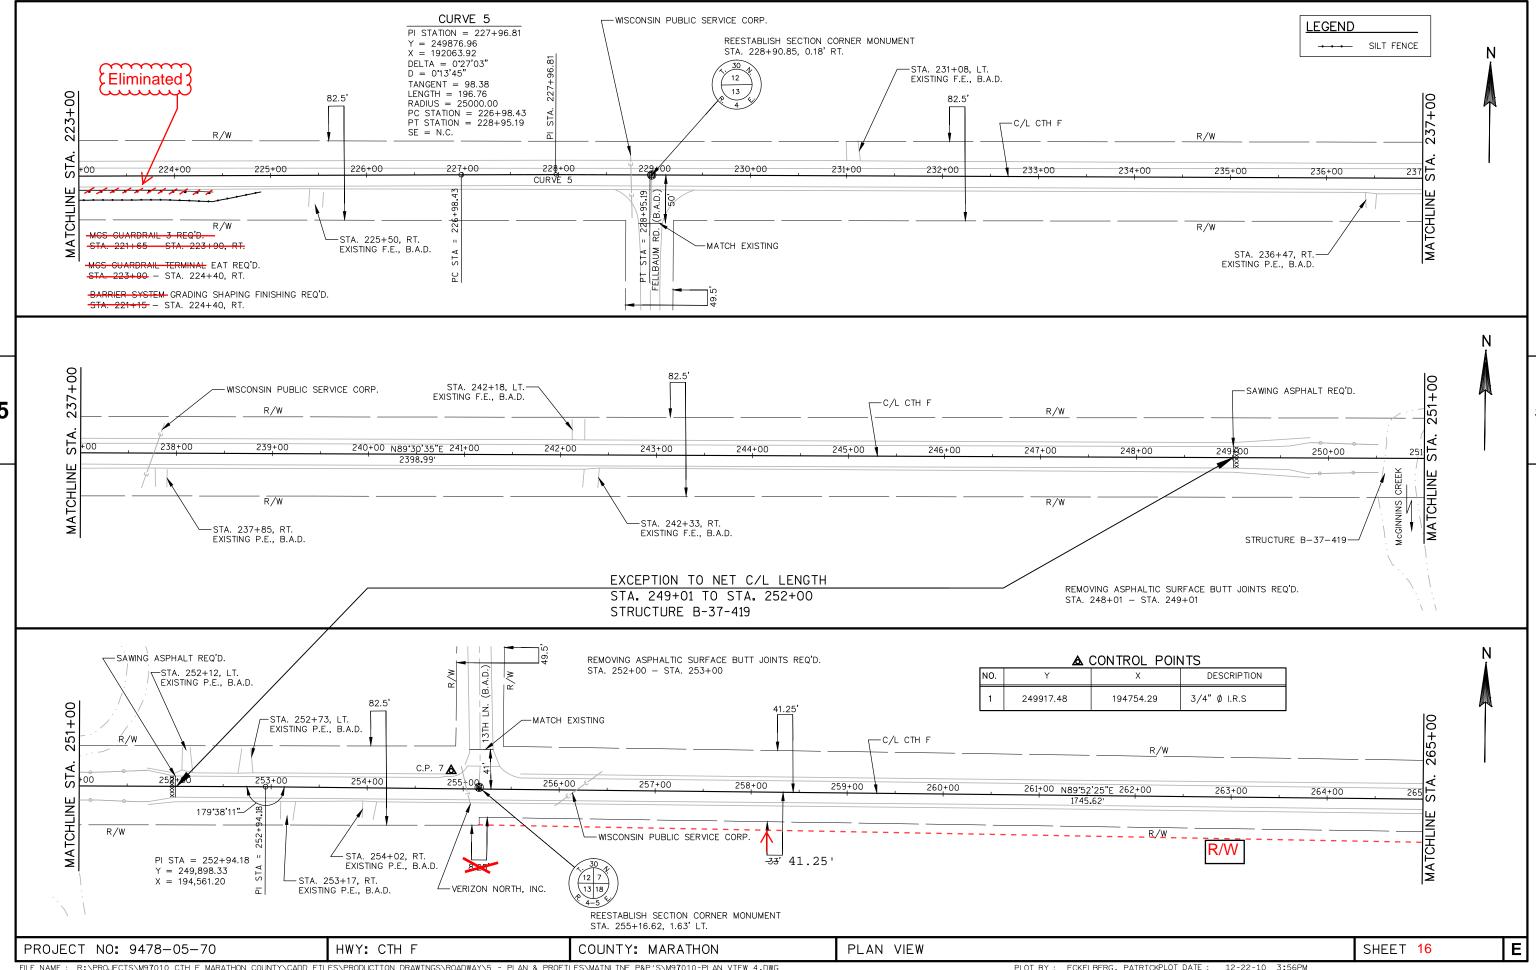


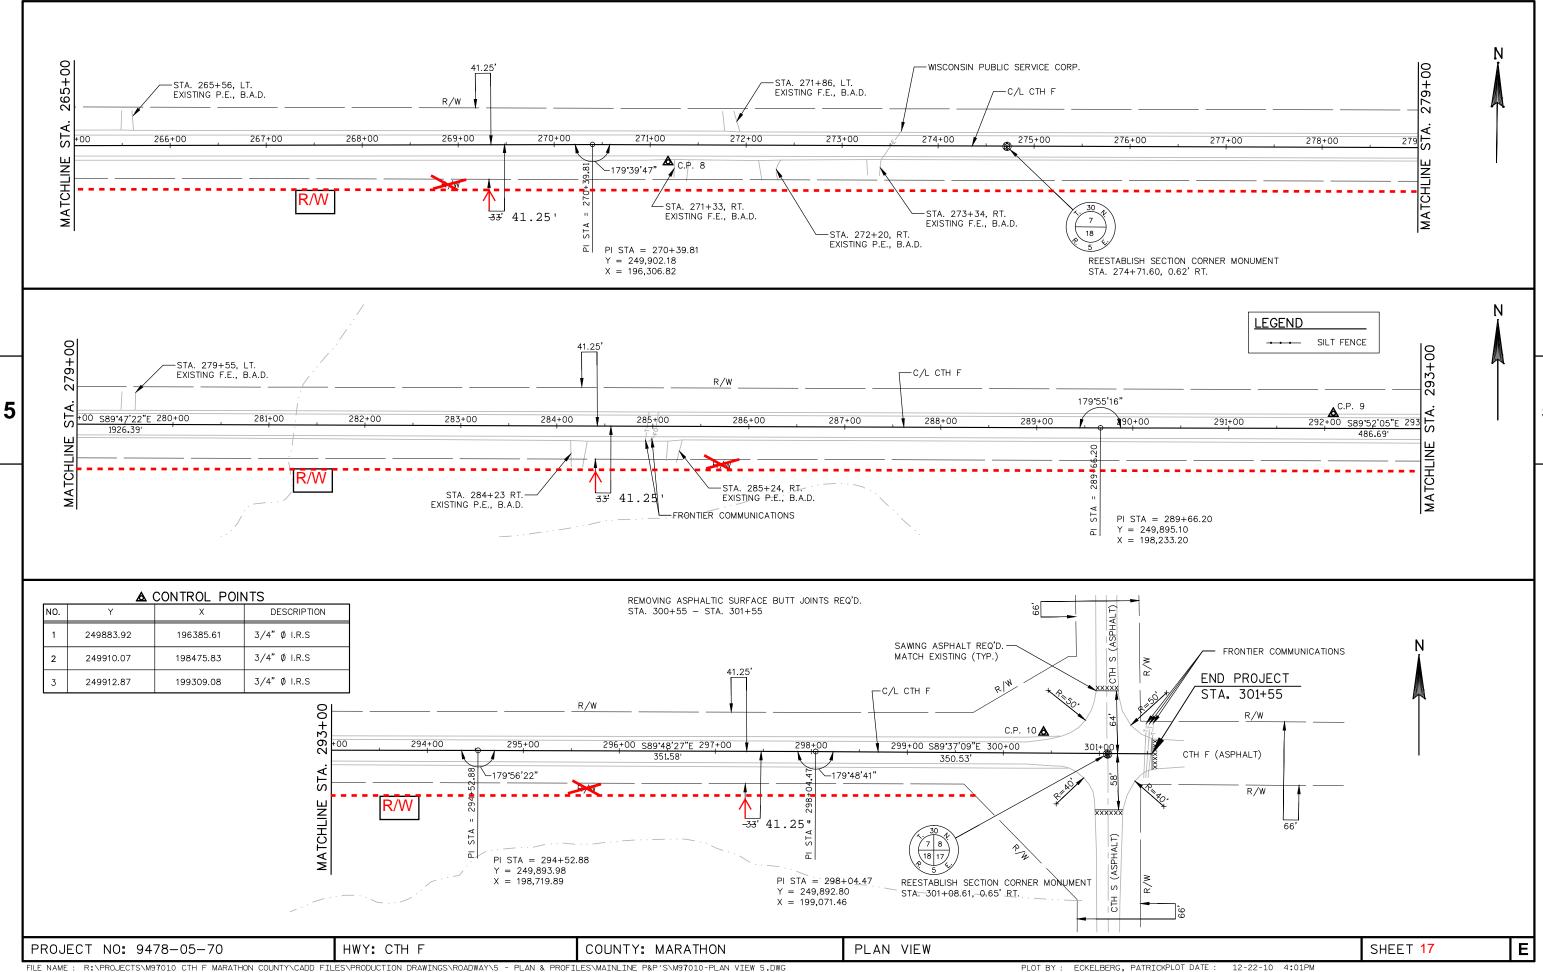





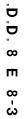


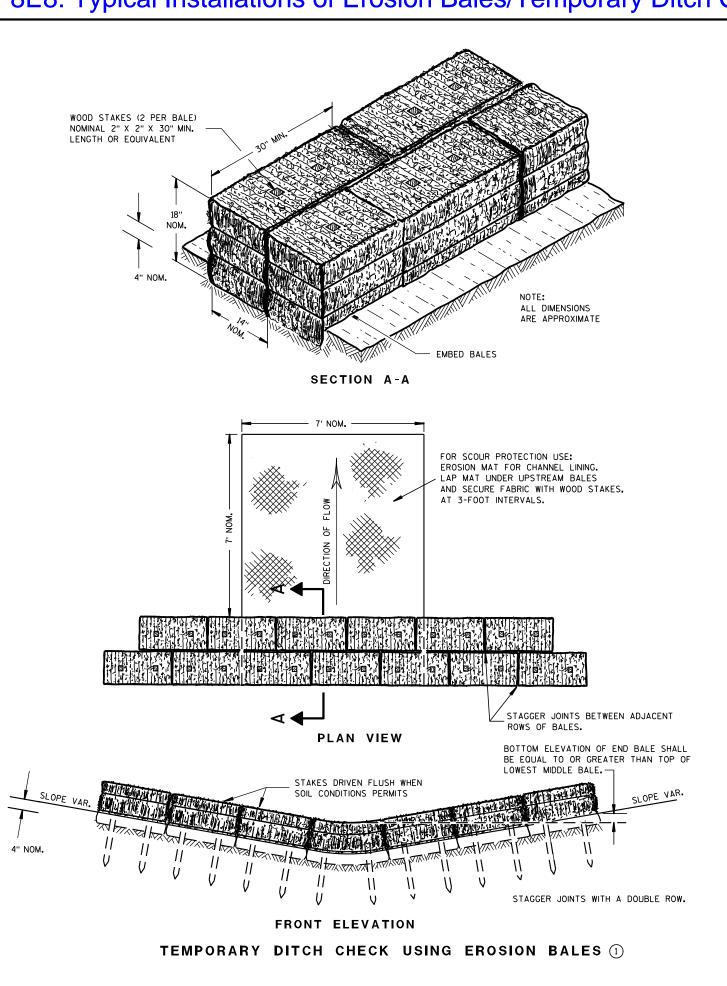


GENERAL NOTES

DETAILS OF CONSTRUCTION, MATERIALS AND WORKMANSHIP NOT SHOWN ON THIS DRAWING SHALL CONFORM TO THE PERTINENT REQUIREMENTS OF THE STANDARD SPECIFICATIONS AND THE APPLICABLE SPECIAL PROVISIONS.


TEMPORARY DITCH CHECKS EITHER EROSION BALES OR MANUFACTURED SHALL BE PAID FOR UNDER THE BID ITEM OF TEMPORARY DITCH CHECK, THE DEPARTMENT WILL NOT PAY FOR TEMPORARY DITCH CHECKS CONSTRUCTED OF A SINGLE ROW OF EROSION BALES.

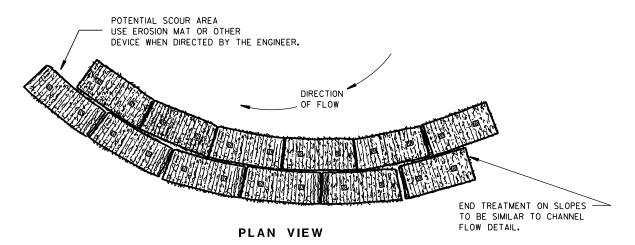

WHEN ALTERING THE DIRECTION OF FLOW

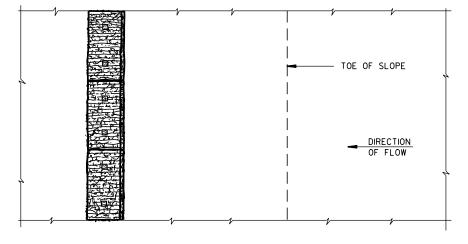

PLAN VIEW

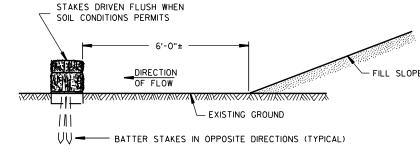

FRONT ELEVATION

WHEN EXISTING GROUND SLOPES AWAY FROM FILL SLOPE

EROSION BALES FOR SHEET FLOW

TYPICAL INSTALLATIONS OF **EROSION BALES / TEMPORARY** DITCH CHECKS

STATE OF WISCONSIN DEPARTMENT OF TRANSPORTATION


APPROVED

/S/ Beth Cannestra
CHIEF ROADWAY DEVELOPMENT ENGINEER


Δ

 ∞

Ш

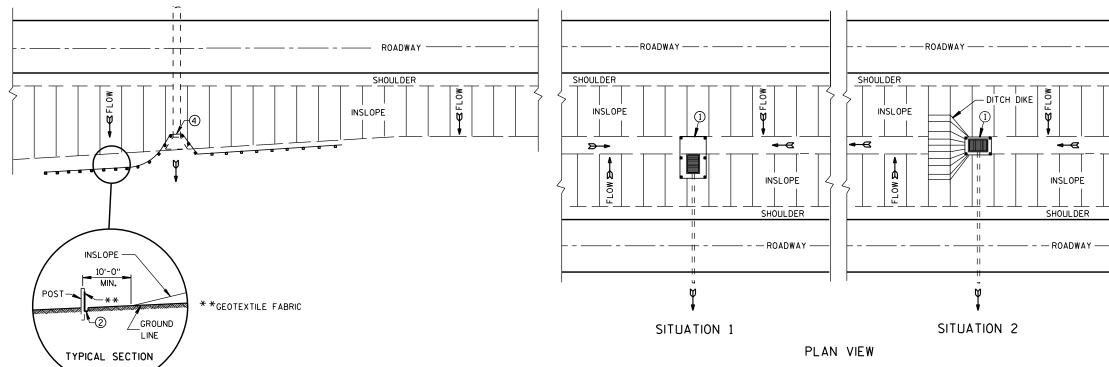


SILT FENCE AT MEDIAN SURFACE DRAINS

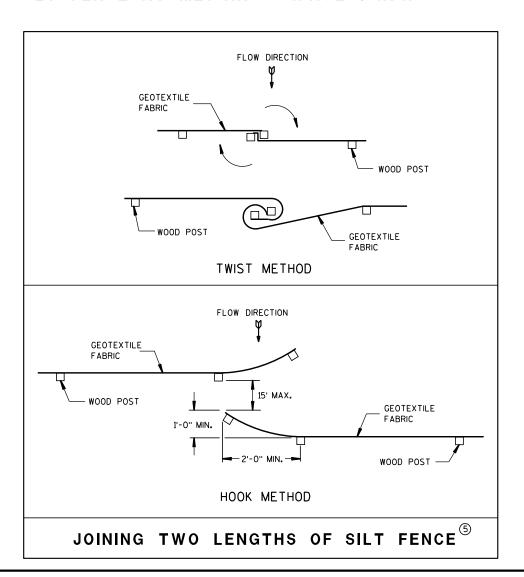

GENERAL NOTES


DETAILS OF CONSTRUCTION NOT SHOWN ON THIS DRAWING SHALL CONFORM TO THE PERTINENT REQUIREMENTS OF THE STANDARD SPECIFICATIONS AND APPLICABLE SPECIAL PROVISIONS.

- \bigcirc HORIZONTAL BRACE REQUIRED WITH 2" X 4" WOODEN FRAME OR EQUIVALENT AT TOP OF POSTS.
- ② FOR MANUAL INSTALLATIONS THE TRENCH SHALL BE A MINIMUM OF 4" WIDE & 6" DEEP TO BURY AND ANCHOR THE GEOTEXTILE FABRIC. FOLD MATERIAL TO FIT TRENCH AND BACKFILL & COMPACT TRENCH WITH EXCAVATED SOIL.
- 3 WOOD POSTS SHALL BE A MINIMUM SIZE OF 11/8" X 11/8" OF OAK OR HICKORY.
- 4) SILT FENCE TO EXTEND ACROSS THE TOP OF THE PIPE.
- (5) CONSTRUCT SILT FENCE FROM A CONTINUOUS ROLL IF POSSIBLE BY CUTTING LENGTHS TO AVOID JOINTS. IF A JOINT IS NECESSARY USE ONE OF THE FOLLOWING TWO METHODS; A) OVERLAP THE END POSTS AND TWIST, OR ROTATE, AT LEAST 180 DEGREES, B) HOOK THE END OF EACH SILT FENCE LENGTH.

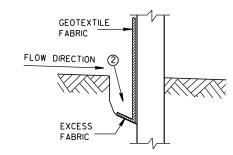


TRENCH DETAIL

6

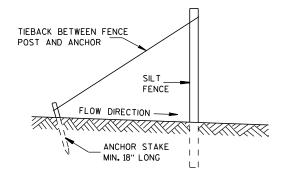

SILT FENCE TIE BACK

(WHEN REQUIRED BY THE ENGINEER)

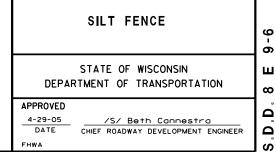

NOTE: ADDITIONAL POST DEPTH OR TIE BACKS MAY BE REQUIRED IN UNSTABLE SOILS 6 SUPPORT CORD WOOD POSTS OR TENSION TAPE LENGTH 4'-0" MIN. GEOTEXTILE _ 2'-0" MIN. DEPTH IN GROUND FLOW_ GEOTEXTILE FABRIC ONLY BACKFILL & COMPACT TRENCH WITH EXCAVATED SOIL ATTACH THE FABRIC TO THE POSTS WITH WIRE STAPLES OR WOODEN LATH AND NAILS b Ō * NOTE: 8'-0" POST SPACING ALLOWED IF A WOVEN GEOTEXTILE FABRIC IS USED.

SILT FENCE

PLAN VIEW

TYPICAL APPLICATION OF SILT FENCE


Δ


			N	METAL	APR	ON EN	NDWAL	.LS			
PIPE	MIN. 1	THICK.				APPROX.					
DIA.	(Incl	nes)	Α	В	Н	٦	ĹΊ	L ₂	W	SLOPE	BODY
(IN.)	STEEL	ALUM.	(±]")	(MAX.)	(±1")	(±1½")	0	0	(±2")	3E01 E	
12	.064	.060	6	6	6	21	12	171/2	24	2½+o 1	1Pc.
15	.064	.060	7	8	6	26	14	213/4	30	21/2+o 1	1Pc.
18	.064	.060	8	10	6	31	15	28 ¹ / ₄	36	$2\frac{1}{2}$ to 1	1Pc.
21	.064	.060	9	12	6	36	18	29%	42	21/2+o 1	1Pc.
24	.064	.075	10	13	6	41	18	371/4	48	2½+o 1	1Pc.
30	.079	. 075	12	16	8	51	18	52 ¹ / ₄	60	21/2 to 1	1Pc.
36	.079	.105	14	19	9	60	24	59¾	72	21/2+o 1	2 Pc.
42	.109	.105	16	22	11	69	24	75 1/8	84	21/2 to 1	2 Pc.
48	.109	.105	18	27	12	78	24	81	90	2 ¹ / ₄ †o 1	3 Pc.
54	.109	.105	18	30	12	84	30	851/2	102	21/4+0 1	3 Pc.
60	.109×	.105×	18	33	12	87	-	-	114	2 to 1	3 Pc.
66	.109×	.105×	18	36	12	87	l	_	120	2 to 1	3 Pc.
72	.109×	.105×	18	39	12	87		_	126	2 to 1	3 Pc.
78	.109×	.105×	18	42	12	87	l	-	132	11/2+0 1	3 Pc.
84	.109×	.105×	18	45	12	87	I	-	138	1½+o 1	3 Pc.
90	.109×	.105×	18	37	12	87		_	144	1½+0 1	3 Pc.
96	.109×	.105×	18	35	12	87	_	_	150	1½+o 1	3 Pc.


	REINFORCED CONCRETE APRON ENDWALLS							
PIPE			DIM	Ensions	(Inches)			APPROX.
DIA.	T	A	В	С	D	Ε	G	SLOPE
12	2	4	24	48 1/8	721/8	24	2	3 to 1
15	21/4	6	27	46	73	30	21/4	3 to 1
18	$2\frac{1}{2}$	9	27	46	73	36	21/2	3 to 1
21	23/4	9	36	371/2	731/2	42	23/4	3 to 1
24	3	91/2	431/2	30	731/2	48	3	3 to 1
27	31/4	101/2	491/2	24	731/2	54	31/4	3 to 1
30	$3\frac{1}{2}$	12	54	193/4	731/2	60	31/2	3 to 1
36	4	15	63	34¾	97¾	72	4	3 to 1
42	$4\frac{1}{2}$	21	63	35	98	78	41/2	3 to 1
48	5	24	72	26	98	84	5	3 to 1
54	51/2		65	**************************************	98 ¹ /4- 100	90	51/2	2½ to 1
60	6	* * * 30-35	60	39	99	96	5	2 to 1
66	61/2	* ** 24-30	* ** 72-78	* * * 21-27	99	102	51/2	2 to 1
72	7	* ** 24-36	78	21	99	108	6	2 to 1
78	71/2	* ** 24-36	78	21	99	114	61/2	2 to 1
84	8	36	901/2	21	1111/2	120	61/2	1½+o 1
90	81/2	41	871/2	24	1111/2	132	61/2	11/2 to 1

THREADED %6" DIA. ROD CONNECTOR AROUND CULVERT & THROUGH TANK TYPE CONNECTOR LUG LUG OR ALTERNATE CONNECTOR STRAP (SEE DETAIL) MEASURED LENGTH OF CULVERT TYPE 1

END SECTION CONNECTOR STRAP

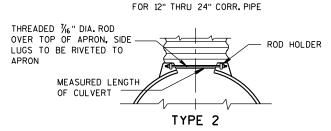

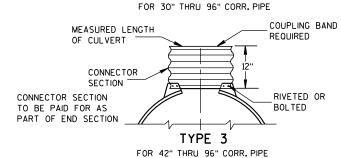

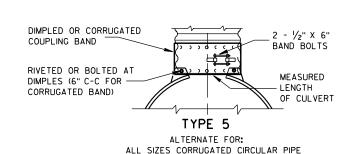

CORRUGATED PIPE.


NOTE: DIMPLED BAND FITS OVER OUTSIDE OF ENDWALL. AND CORRUGATED BAND FITS INSIDE ENDWALL. DIMPLED BAND MAY BE USED WITH HELICALLY

> FOR CIRCUMFERENTIALLY CORRUGATED PIPE USE ENDWALL CONNECTION DETAILS 1, 2, 3 OR 5


FOR HELICALLY CORRUGATED PIPE USE ENDWALL CONNECTION DETAILS 1, 2 OR 5.


FOR HELICALLY CORRUGATED PIPES WITH TWO CIRCUMFERENTIAL CORRUGATIONS AT EACH END USE ENDWALL CONNECTION DETAILS 1, 2 OR 3.

CONNECTION DETAILS

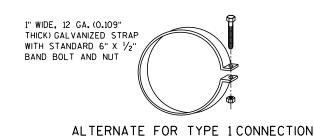


	16	22	11	69	24	755/8	84	21/2 to 1	2 Pc.
	18	27	12	78	24	81	90	2 ¹ / ₄ +o 1	3 Pc.
	18	30	12	84	30	851/2	102	2 ¹ / ₄ †o 1	3 Pc.
×	18	33	12	87	-	-	114	2 to 1	3 Pc.
×	18	36	12	87	l	l	120	2 to 1	3 Pc.
×	18	39	12	87	l	I	126	2 to 1	3 Pc.
×	18	42	12	87	l	-	132	11/2+0 1	3 Pc.
X	18	45	12	87	-	-	138	11/2 to 1	3 Pc.
X	18	37	12	87	_	_	144	1½+o 1	3 Pc.
×	18	35	12	87	ı	ı	150	1½+o 1	3 Pc.
	× EXCEPT CENTER PANEL SEE GENERAL NOTES								

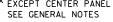


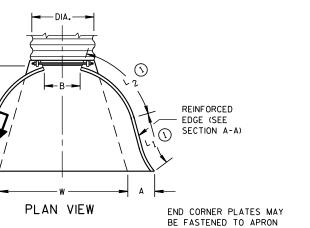


PROPER BY BOLTS, RIVETS, OR RESISTANCE SPOT WELDS WHICH WILL HOLD THE SURFACES TIGHTLY TOGETHER END CORNER 1/16" DIA. HOLES FOR TOE PLATE (SAME THICKNESS BOLTS OR RIVETS -AND METAL AS APRON) SHALL BE FURNISHED WHEN CALLED 12" C-C MAX. SPACING FOR ON THE PLANS END VIEW

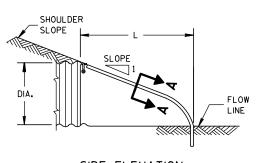


SIDE ELEVATION METAL ENDWALLS

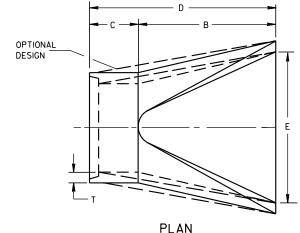


**MAXIMUM

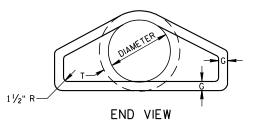

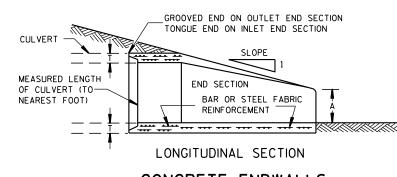

CONCRETE ENDWALLS

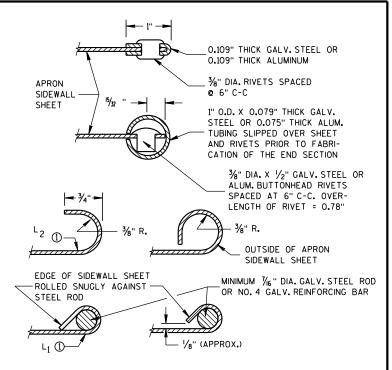

SECTION A-A

GENERAL NOTES

DETAILS OF CONSTRUCTION, MATERIALS AND WORKMANSHIP NOT SHOWN ON THIS DRAWING SHALL CONFORM TO THE PERTINENT REQUIREMENTS OF THE STANDARD SPECIFICATIONS AND THE APPLICABLE SPECIAL PROVISIONS.

CONCRETE CULVERT ENDWALLS MAY NOT BE USED WITH GALVANIZED STEEL OR ALUMINUM CULVERT PIPE OR VISE VERSA, GALVANIZED STEEL OR ALUMINUM ENDWALLS SHALL NORMALLY BE INSTALLED ON CULVERT PIPE OF THE SAME METAL.

ALL THREE PIECE STEEL APRON ENDWALLS FOR 60" DIAMETER PIPE AND LARGER SHALL HAVE 0.109" SIDES AND 0.138" CENTER PANELS. ALL THREE PIECE ALUMINUM APRON ENDWALLS FOR 60" DIAMETER PIPE AND LARGER SHALL HAVE 0.105" SIDES AND 0.134" CENTER PANELS. THE WIDTH OF CENTER PANELS SHALL BE GREATER THAN 20 PERCENT OF THE PIPE

LAP SEAMS SHALL BE TIGHTLY JOINED BY GALVANIZED RIVETS OR BOLTS FOR STEEL UNITS AND ALUMINUM RIVETS AND BOLTS FOR ALUMINUM UNITS. FOR THE 60" THROUGH 96" DIAMETER APRON ENDWALL SIZES. THE REINFORCED EDGES AND CENTER PANEL SEAMS SHALL BE FURTHER REINFORCED WITH GALVANIZED STEEL OR ALUMINUM STIFFENER ANGLES. THE ANGLES SHALL BE ATTACHED BY GALVANIZED NUTS AND BOLTS FOR STEEL UNITS AND ALUMINUM NUTS AND BOLTS FOR ALUMINUM UNITS.

WHERE TWO OR MORE PIPES WITH APRON ENDWALLS ARE LAID ADJACENT TO EACH OTHER, THEY SHALL BE SEPARATED BY A DISTANCE SUFFICIENT TO PROVIDE A MINIMUM CLEARANCE OF 6 INCHES BETWEEN APRON ENDWALLS.

(1) FOR PIPE SIZES UP TO 60" DIAMETER, A 180° ROLLED EDGE MAY BE USED INSTEAD OF STEEL ROD REINFORCEMENT. SEE SECTION A-A.



DEPARTMENT OF TRANSPORTATION

/S/ Rory L. Rhinesmith CHIEF ROADWAY DEVELOPMENT ENGINEER

6

Ö

D

EYE BOLT AND TIE ROD ASSEMBLY (ALTERNATE NO. 1)

GENERAL NOTES


DETAILS OF CONSTRUCTION, MATERIALS, AND WORKMANSHIP NOT SHOWN ON THIS DRAWING SHALL CONFORM TO THE PERTINENT REQUIREMENTS OF THE STANDARD SPECIFICATIONS AND APPLICABLE SPECIAL PROVISIONS.

CONCRETE CULVERT AND STORM SEWER PIPE SHALL BE TIED TOGETHER IN THE MANNER ILLUSTRATED BY THIS DETAIL AT LOCATIONS DESIGNATED IN THE STANDARD SPECIFICATIONS AND THE PLAN. THE CONTRACTOR MAY USE EITHER ALTERNATE 1, 2 OR 3 FOR DRAINAGE STRUCTURES, ONLY ALTERNATE 1 AND 3 MAY BE USED FOR CATTLE PASSES, UNLESS OTHERWISE STATED IN THE CONTRACT. THE MATERIALS, FABRICATION AND WORK NECESSARY TO TIE THE PIPE BY THIS DETAIL WILL BE CONSIDERED INCIDENTAL TO THE PIPE AND APRON ENDWALLS IF REQUIRED.

DETAILED DRAWINGS FOR PROPOSED ALTERNATE DESIGNS FOR JOINT TIES SHALL BE SUBMITTED TO THE ENGINEER FOR APPROVAL.


JOINT TIES TO BE HOT-DIP GALVANIZED PER ASTM A 153.

- (1) & OF TONGUE AND GROOVE OR BELL AND SPIGOT JOINTS.
- THE INSIDE OF THE THREADED INSERTS SHALL BE CLEAN TO ALLOW THE INSERTION OF THREADED EYE
- ${\mathfrak S}$ HOLES SHALL BE CAST-IN-PLACE OR DRILLED 12 INCHES FROM ${\mathfrak L}$ OF TONGUE AND GROOVE.
- 4 BOLT PROJECTION INSIDE OF PIPE SHALL NOT EXCEED 2 INCHES.
- (5) OPENING TO BE ROD DIAMETER PLUS 1 INCH.
- ⑥ LENGTH ADEQUATE TO EXTEND TO WITHIN $rac{1}{2}$ INCH OF THE INNER SURFACE OF THE PIPE.

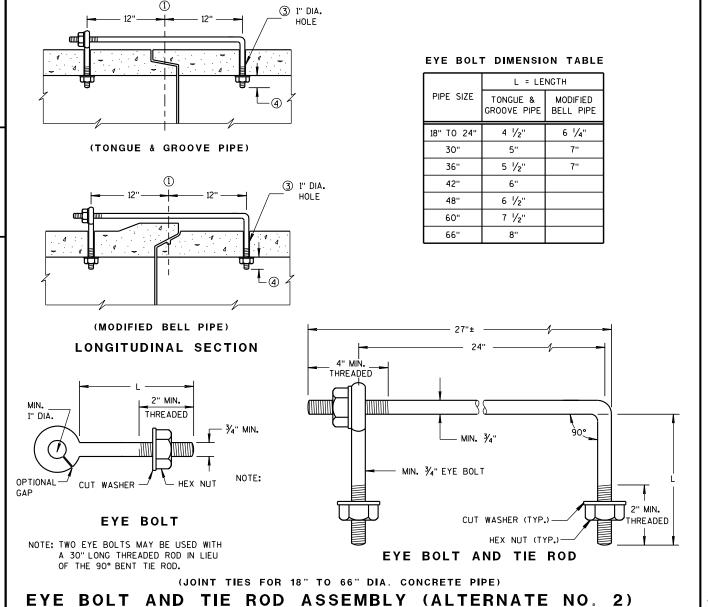


ADJUSTABLE TIE ROD TABLE 5/8 5 12-60 3/4 5 1/2 3/4 90-108 DIMENSIONS SHOWN ARE IN INCHES



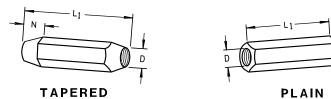


RIGHT AND LEFT THREADS

SLEEVE NUTS

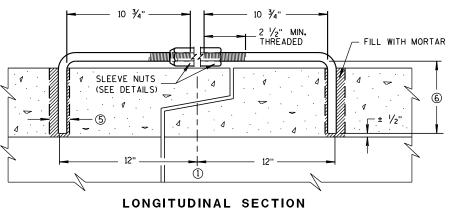


(JOINT TIES FOR 12" TO 108" DIA. CONCRETE PIPE)

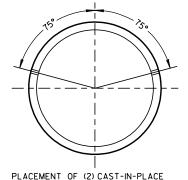

INSERTS OR HOLES DURING FABRICATION FOR PIPE SECTIONS REQUIRING TIE RODS

TRANSVERSE SECTION

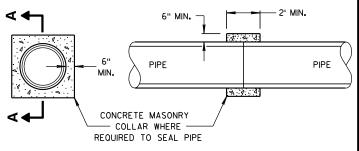

SECTION A-A

CONCRETE COLLAR DETAIL

JOINT TIES FOR CONCRETE PIPE AND CONCRETE COLLAR DETAIL


STATE OF WISCONSIN DEPARTMENT OF TRANSPORTATION


6/5/2012 /S/ Jerry H. Zogg ROADWAY STANDARDS DEVELOPMENT ENGINEER

 ∞

Ω


ADJUSTABLE TIE ROD (ALTERNATE NO. 3)

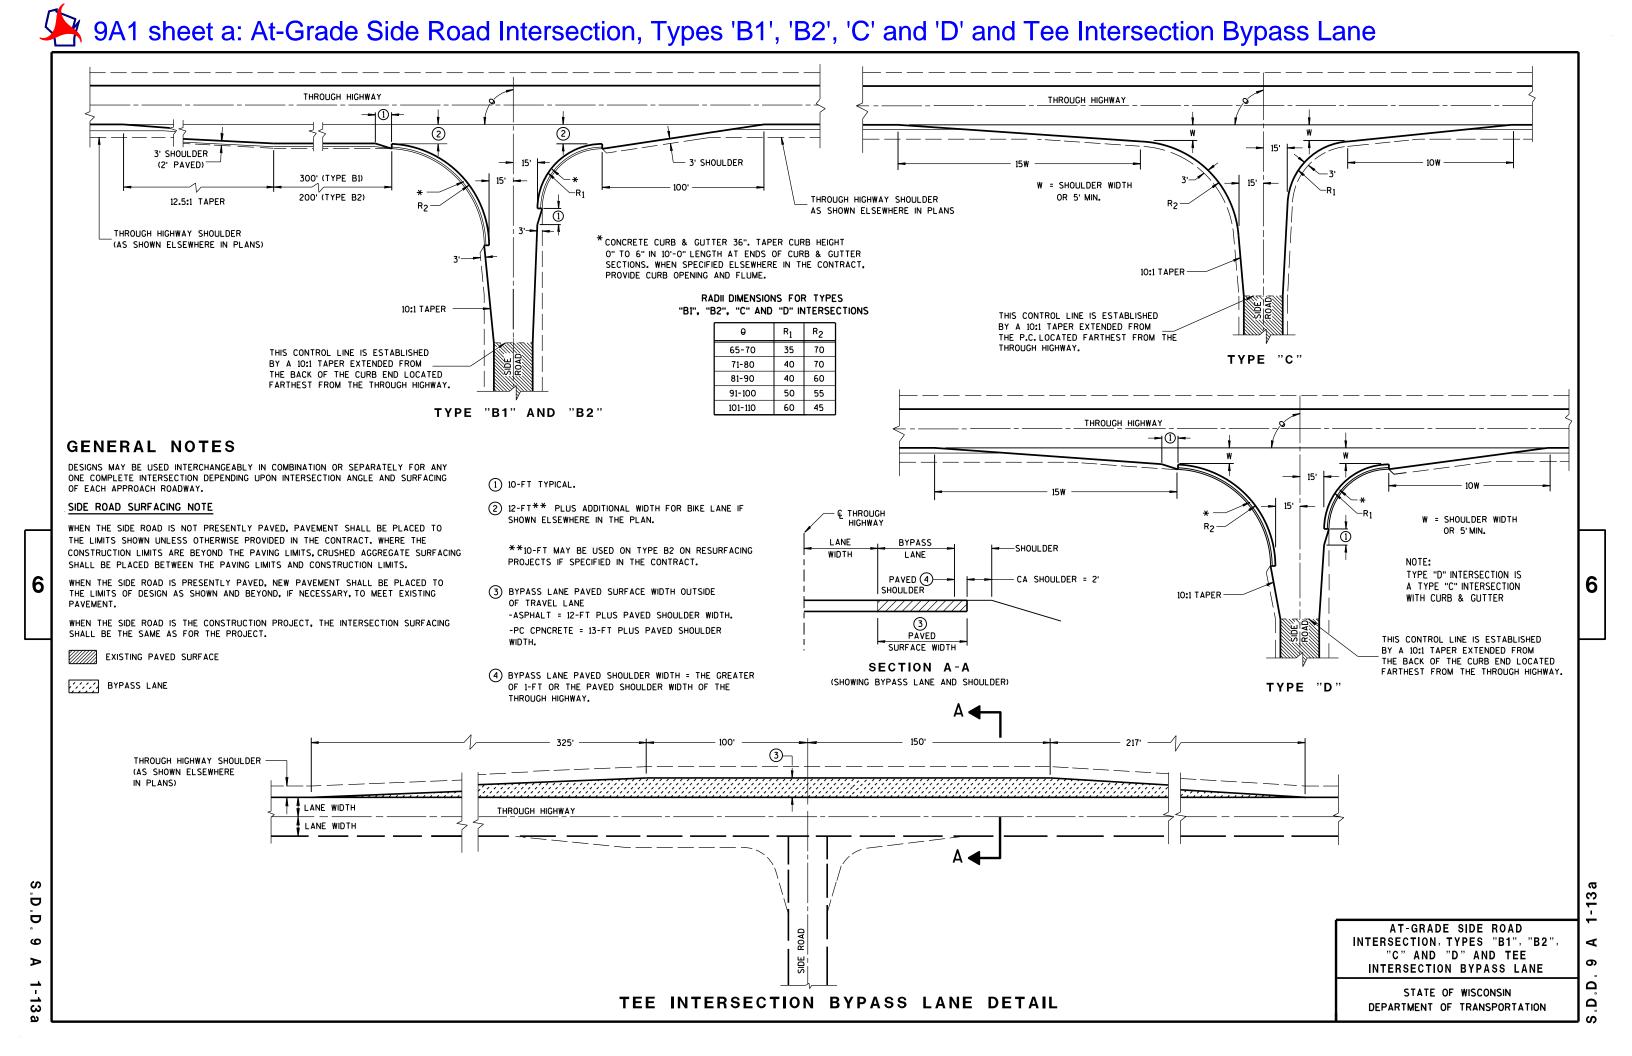

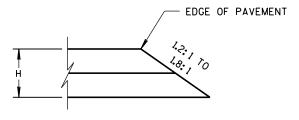


CONSTRUCTED WITH FINAL TWO LAYERS

FOR H 5" OR LESS

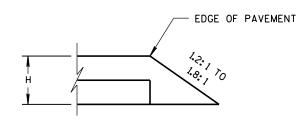


CONSTRUCTED WITH FINAL LAYER

FOR H 5" OR LESS

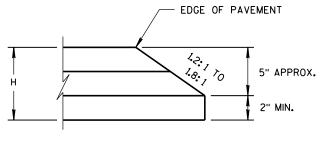


CONSTRUCTED WITH FINAL TWO LAYERS

FOR H GREATER THAN 5"

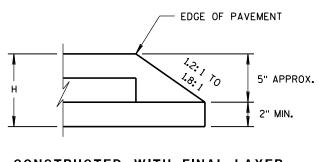

FOR H GREATER THAN 5"

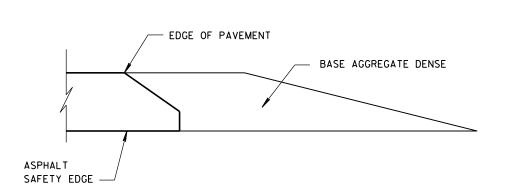

FINISHED SHOULDER AGGREGATE PLACEMENT

HMA PAVEMENT AND HMA OVERLAYS

SAFETY EDGE SM

STATE OF WISCONSIN
DEPARTMENT OF TRANSPORTATION

6

 $\mathbf{\omega}$

Ω

Δ

APPROVED

DATE ROADWAY STANDARDS DEVELOPMENT ENGINEER


S.D.D. 14 B 29-1

6

14B42 sheet a: Midwest Guardrail System (MGS) Installation Cross Sections, Post and Block Details


GENERAL NOTES

- WOOD OR STEEL POSTS (w6X9 OR w6X8.5) MAY BE USED. DO NOT INTERMIX WOOD AND STEEL POSTS. INSTALL STEEL POSTS WITH HOLES ON APPROACHING TRAFFIC SIDE.
- USE WOOD OR APPROVED PLASTIC BLOCKOUTS. WOOD BLOCKOUTS MAY BE CONSTRUCTED OUT OF TWO OR MORE WOOD BLOCKOUTS. SEE ALTERNATE WOOD BLOCKOUT DETAIL. DIMENSIONS OF APPROVED PLASTIC BLOCKOUTS MAY VARY.
- (3) IF ROCK IS ENCOUNTERED DURING EXCAVATION, PROVIDE A HOLE 12 INCHES IN DIAMETER EXTENDING 20 INCHES DEEP INTO THE ROCK. PLACE APPROXIMATELY 21/2INCHES OF GRANULAR MATERIAL IN THE BOTTOM OF THE HOLE. CUT THE POSTS THE TO LENGTH AMD INSTALL. BACKFILL WITH EXCAVATED MATERIAL AND COMPACT. BACKFILL IS TO BE FREE OF LARGE ROCKS.
- (4) WHEN THE DISTANCE FROM BACK OF POST TO SHOULDER HINGE POINT IS LESS THAN 2 FEET INSTALL LONGER POST AT HALF POST SPACING (K).
- (5) FOR NEW MGS INSTALLATION TOP OF W-BEAM RAIL TOLERANCE IS ± 1". FOR EXISTING MGS INSTALLATION TOP OF W-BEAM IS BETWEEN 273/4" TO 32".

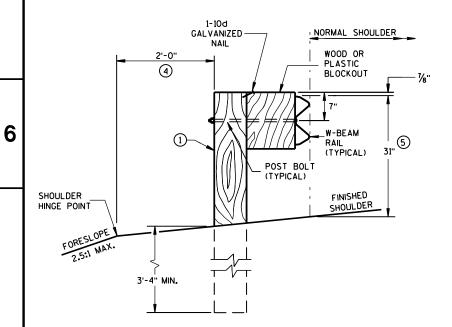


END VIEW


LOCATED ALONG A ROADWAY SHOULDER STANDARD INSTALLATION

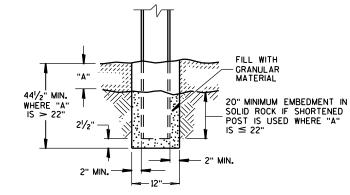


SETTING STEEL OR WOOD POST IN ROCK $^{\cite{3}}$

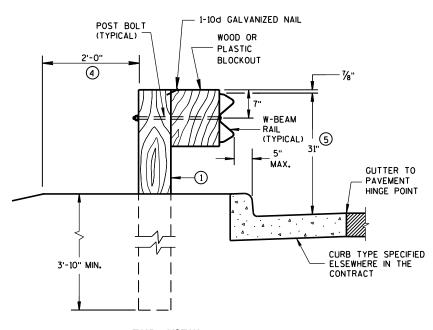


END VIEW
LOCATED ALONG A CURBED ROADWAY

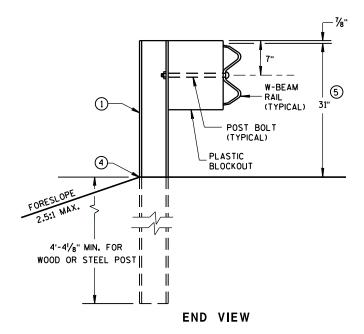


MGS LONGER POST AT HALFPOST SPACING W BEAM (K)

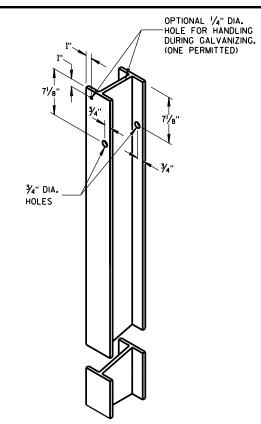


STEEL POST & HOLE PUNCHING DETAIL (w6X9)

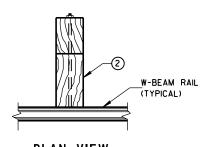


PLAN VIEW
WOOD POST,
BLOCKOUT & BEAM

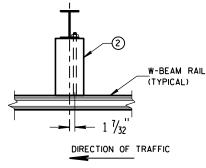

PLAN VIEW
STEEL POST,
PLASTIC BLOCKOUT & BEAM

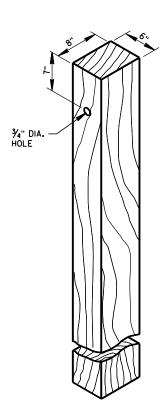

WOOD POST (6" X 8") NOMINAL

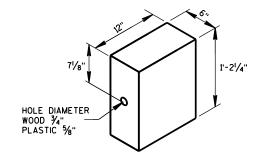

WOOD OR PLASTIC BLOCKOUT

MIDWEST GUARDRAIL SYSTEM (MGS) GUARDRAIL

STATE OF WISCONSIN
DEPARTMENT OF TRANSPORTATION

.D.D. 14 B 42

D.D. 14 E

N


6

14B42 sheet b: Midwest Guardrail System (MGS) Bolt, Alternative Wood Block, and Additional block or Adjusting post spacing for (

12'-6" OR 25'-0" EFFECTIVE LENGTH OF BEAM 6'-3" C-C POST SPACING POST SPACING FINISHED SHOULDER DIRECTION OF TRAFFIC


FRONT VIEW

POST SPACING STANDARD INSTALLATION

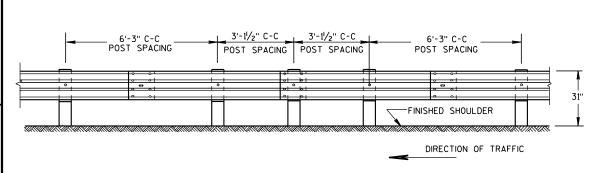


FRONT VIEW


HALF POST SPACING (HS) AND HALF POST SPACING WITH LONGER POSTS (K)

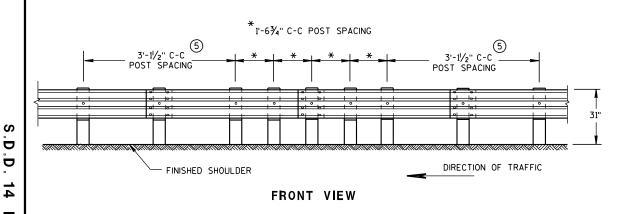


QUARTER POST SPACING (QS)

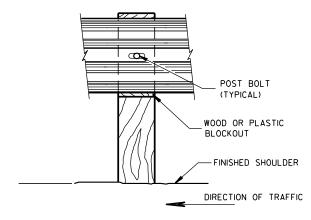

FRONT VIEW AT WOOD POST

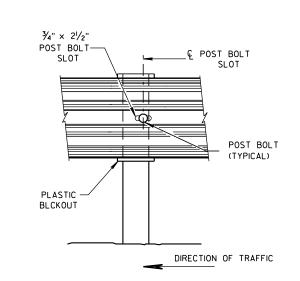

FRONT VIEW AT STEEL POST

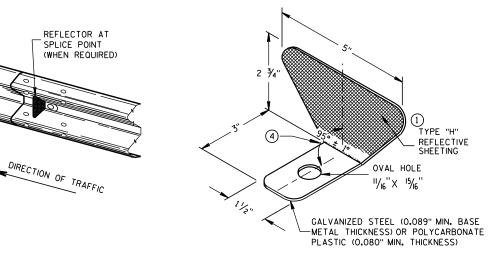


ONE SIDED REFLECTOR DETAIL AND TYPICAL INSTALLATION

GENERAL NOTES


- 1 PROVIDE TYPE "H" SILVER REFLECTIVE SHEETING ON ALL REFLECTORS EXCEPT THOSE LOCATED ALONG THE LEFT EDGE OF ONE-WAY ROADWAYS, WHICH SHALL BE PROVIDED WITH TYPE "H" YELLOW REFLECTIVE SHEETING.
- ② DO NOT INSTALL REFLECTORS ON THE FIRST 50 FEET OF THE APPROACH END OF THE ENERGY ABSORBING TERMINAL. RAIL SPLICE LOCATIONS ARE THE ONLY ACCEPTABLE LOCATIONS FOR REFLECTORS.
- (3) REVERSE EVERY OTHER REFLECTOR FOR 2-WAY VISIBILITY. THE CONTRACTOR MAY FURNISH TWO-SIDED REFLECTORS IN LIEU OF ONE-SIDED REFLECTORS.
- (4) PROVIDE AN ANGLE OF BEND OF 90° ± 1° FOR TWO-SIDED REFLECTORS.
- (5) 25 FEET OF HALF POST SPACING IS REQUIRED ON APPROACH AND DEPARTURE ENDS OF QUARTER POST SPACING.

POST BOLTS ARE A 5%" DIAMETER ASTM A307 GUARDRAIL BOLT. A POST BOLT REQUIRES 5%" DIAMETER A563A DOUBLE RECESSED (DR) HEAVY HEX NUT AND 5%" DIAMETER F844 FLAT WASHER. POST BOLTS MAY BE LONGER IF MULTIPLE BLOCKOUTS ARE BEING USED.

GUARD RAIL SPLICE BOLTS ARE A $\frac{1}{8}$ " DIAMETER ASTM A307 GUARDRAIL HEAD BOLT. A GUARDRAIL SPLICE BOLT REQUIRES $\frac{1}{8}$ " DIAMETER A563A DOUBLE RECESSED (DR) HEAVY HEX NUT.

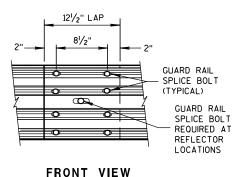

MID-SPAN BEAM SPLICE

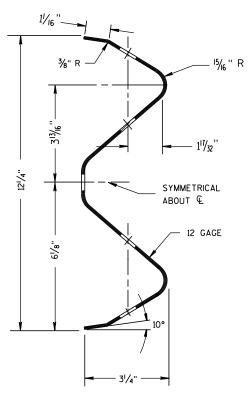

SECTION THRU W-BEAM RAIL

REFLECTOR SPACING

	BEAM GUARD		NO. SURFACES	MIN. NO.	
	LENGTH	SPACING	REFLECTORIZED	REFLECTORS	
ONE WAY TRAFFIC	< 200' > 200'	50' C-C 100' C-C	1 1	3	
TWO WAY TRAFFIC	< 200' > 200'	25' C-C 50' C-C	1 3	6	
TWO WAY TRAFFIC	< 200' > 200'	50' C-C 100' C-C	2 4	3	


MIDWEST GUARDRAIL SYSTEM (MGS) GUARDRAIL

STATE OF WISCONSIN
DEPARTMENT OF TRANSPORTATION

S.D.D. 14 B 42-2b

DETAIL FOR 16" BLOCKOUT DEPTH

IT IS ACCEPTABLE TO USE BLOCKOUTS UP TO 16" DEEP TO INCREASE THE POST OFFSET TO AVOID UNDERGROUND OBSTACLES. THERE IS NO LIMIT TO THE NUMBER OF POSTS THAT CAN HAVE ADDITIONAL BLOCKOUTS UP TO 16" DEEP.

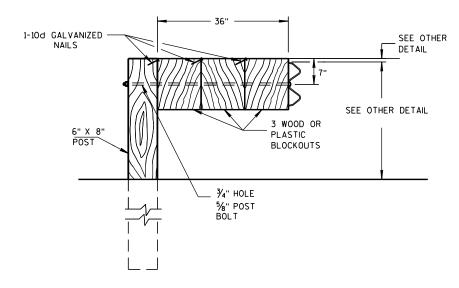


DETAIL FOR 36" BLOCKOUT DEPTH

NOTES: UNDER SPECIAL CIRCUMSTANCES, SUCH AS AVOIDING OBSTACLES THAT ARE NOT RELOCATED, IT IS ACCEPTABLE TO INSTALL ADDITIONAL BLOCKOUTS TO OBTAIN UP TO 36" DEPTH FOR ONE OR TWO POSTS IN A SECTION OF GUARDRAIL.

DO NOT USE 16" OR 36" BLOCKOUTS IF IT CAUSES THE POST TO BE DRIVEN BEYOND SHOULDER HINGE POINT OR CAUSES A FIXED OBJECT TO BE WITHIN THE DEFLECTION DISTANCE OF THE BARRIER.


NOTE: 1. ALL FILLETS SHALL HAVE A MINIMUM RADIUS OF $\frac{1}{16}$ ".

2. IF THE BOLT EXTENDS MORE THAN $\frac{1}{4}$ " FROM THE NUT THE BOLT SHOULD BE TRIMMED BACK.

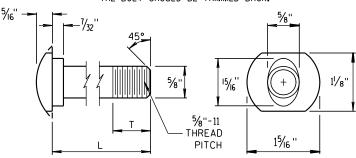


POST BOLT TABLE


L	T (MIN.)
11/4"	1 1/8"
2"	13/4"
10"	4"
14"	4½ ₆ "
18"	4"
21"	4½ "
25"	4"

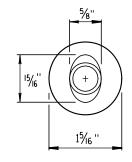


ALTERNATE BOLT HEAD

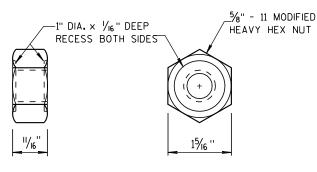


POST BOLT AND RECESS NUT

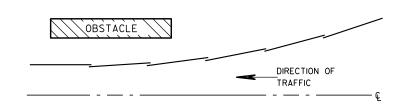


PLAN VIEW BEAM LAPPING DETAIL

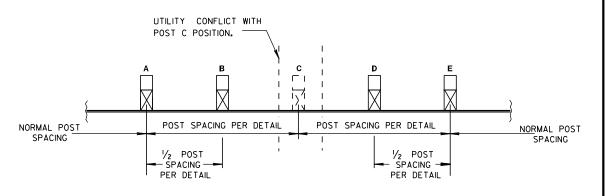

POST DRIVING FOR CONTINUOUS UNDERGROUND OBSTRUCTION

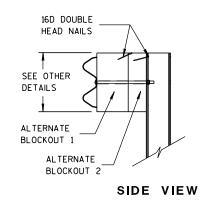

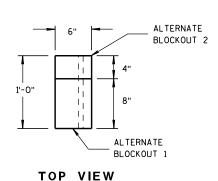

ALTERNATE WOOD BLOCKOUT DETAIL

MIDWEST GUARDRAIL SYSTEM (MGS) GUARDRAIL

STATE OF WISCONSIN
DEPARTMENT OF TRANSPORTATION


S.D.D. 14 B

6


S.D.D. 14 B 42

CLEAR ZONE LIMITS, EITHER AS SHOWN ELSEWHERE IN THE PLANS OR, IF NOT SHOWN ELSEWHERE IN THE PLANS, 15 FEET BEYOND THE HINGE POINT LINE A I SLOPE 15:1 TAPER EXTENDED VEHICLE **GENERAL NOTES** HINGE POINT LINE RUNOUT PATH (EVRP) VARIABLE SLOPE A THE SLOPE IN THE AREA BOUNDED BY THE EXTENDED VEHICLE RUNOUT 5'-0" MIN. PATH (EVRP), THE HINGE POINT LINE (HPL), AND THE CLEAR ZONE LIMITS TO HINGE (CZL) SHALL BE 4:1 OR FLATTER. $\begin{picture}(60,0)\put(0,0){\line(0,0){10}}\put(0,0){\line(0,0){10}$ PARALLEL WITH TRAVELED WAY C DIFFERENT MANUFACTURES REQUIRE DIFFERENT PERFORATED W-BEAM SLOPE RAIL END PANELS. SEE MANUFACTURES INFORMATION. 10:1 MAX. SLOPE 10:1 OR FLATTER TO HINGE POINT (D) THE TOP OF THE STEEL TUBE ON POST 1 AND POST 2 SHALL NOT BE MORE THAN 3" ABOVE THE FINISH GROUND ELEVATION. ∠_ 25:1 FLARE EDGE OF SHOULDER 2'-0" OFFSET TO **6** FACE OF RAIL (F) SHEETING IS ATTACHED TO 0.040 ALUMINUM SHEET AND ATTACHED TO E.A.T. HEAD USING 4 STAINLESS STEEL SELF-TAPPING SCREWS. **PLAN** DIRECTION OF TRAFFIC ONE SCREW PER CORNER OF E.A.T. GUARD (MGS) SYSTEM LENGTH = 53'-11/2" (G) 1/2" DIAMETER X 3" LONG LAG BOLT AND WASHER. WOOD BREAKAWAY 12 SEE DETAIL "B" DETAILS) H HARDWARE VARIES BETWEEN DIFFERENT MANUFACTURES. SEE POSTS IN -MANUFACTURE'S DRAWING FOR INFORMATION. FOUNDATION TUBES (I) DIMENSIONS MAY VARY. SEE MANUFACTURE'S INFORMATION. -(11) -4" POSTS 1-4 (TYPICAL) SEE SDD 14B42 FOR MORE INFORMATION. * DO NOT ATTACH BLOCKOUTS TO POSTS 1 AND 2. 10— DO NOT INSTALL REFLECTORS ON THE FIRST 50 FEET OF THE APPROACH END OF THE ENERGY ABSORBING TERMINAL. W-BEAM RAIL SPLICES ARE LOCATED AT POST NUMBER 3, AND BETWEEN SEE NOTES FOR POST 5 AND 6, BETWEEN POSTS 7 AND 8, AND MIDDLE OF THE SPAN AFTER POST 9. SPLICE LOCATION SEE DETAIL "A" (3)-3-PATTERN AND COLORS ON REFLECTIVE SHEETING TYPE H ARE TO THE CENTER OF THE UPPER 3½" DIAMETER HOLE ON POST NUMBER 3 THROUGH POST 9 IS TO BE FLUSH WITH THE GROUND LINE (\pm $\frac{3}{2}$ ") POST NO. 5 POST NO. 4 POST NO. 3 POST NO. 8 POST NO. 7 POST NO.6 POST NO. 9 POST NO. 2 * POST NO.1 * **ELEVATION** -(12) 0 2'-0" TO 3'-0" VAR. 7 9 POST BOLT (TYP.) DETAIL "A - EDGE OF SHOULDER 5'-0" MIN. POST BOLT 2'-0" OFFSET TO_ FINISHED GROUND TO HINGE POINT (TYP.) FACE OF RAIL BOTTOM OF STRUT IS PLACED FLUSH WITH AND PARALLEL TO SHOULDER OR FLATTER HINGE POINT SHOULDER POINT OR FLATTER SLOPE 10:1 OR FLATTER DETAIL SLOPE 4:1 POST NO. 2 POST NO. 1 Ē 3 1/2" HOLES MIDWEST GUARDRAIL SYSTEM **ENERGY ABSORBING TERMINAL** TRANSITION TO 4:1 TAPER LINE (MGS) NORMAL SLOPE SECTION A-A SECTION B-B SECTION C-C TYPICAL AT POST NO. 1 STATE OF WISCONSIN TYPICAL AT POST NO. 2 TYPICAL AT POST NOS. 3-9 DEPARTMENT OF TRANSPORTATION



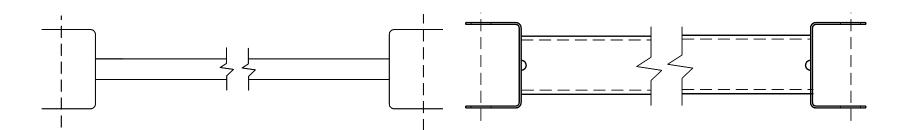


9 H GENERIC GROUND STRUT

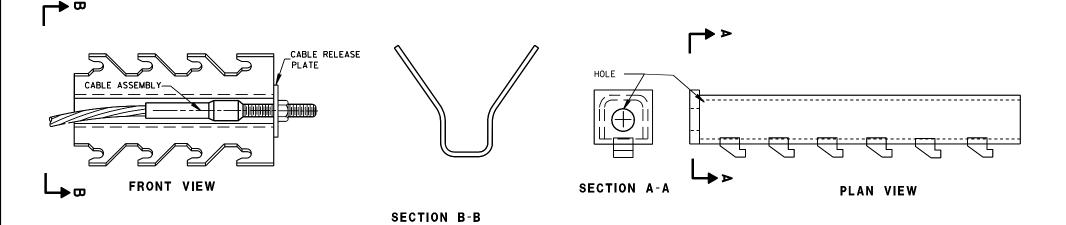

GENERIC ANCHOR CABLE BOX

BILL OF MATERIALS

PART NO.	DESCRIPTION MATERIALS PROVIDED BY MGS EAT MANUFACTURER. SEE MANUFACTURER'S DETAILS FOR MORE INFORMATION.
1	WOOD BREAKAWAY POST
2	6" X 8" X 0.188", 6'-0" LONG FOUNDATION TUBE AT POSTS 1AND 2
3	WOOD CRT
4	WOOD BLOCKOUT
(5)	PIPE SLEEVE
6	BEARING PLATE
7	BCT CABLE ASSEMBLY
8	ANCHOR CABLE BOX
9	GROUND STRUT
10	PERFORATED W-BEAM RAIL END PANEL, 12'-6" LONG.
(11)	STANDARD W-BEAM RAIL.MULTIPLE SECTIONS REQUIRED. SECTIONS VARY IN LENGTH.
(12)	END SECTION EAT
(13)	0.040" ALUMINUM SHEET WITH REFLECTIVE SHEETING TYPE H (ONLY THE SHEETING IS SUPPLIED BY THE MANUFACTURER)
(14)	EAT MARKER POST - YELLOW (SEE APPROVED PRODUCTS LIST)

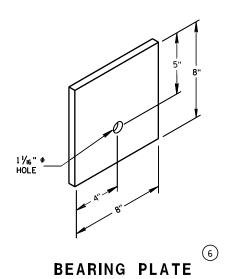


MIDWEST GUARDRAIL SYSTEM ENERGY ABSORBING TERMINAL (MGS)


STATE OF WISCONSIN DEPARTMENT OF TRANSPORTATION


S.D.D.

6

S.D.D.

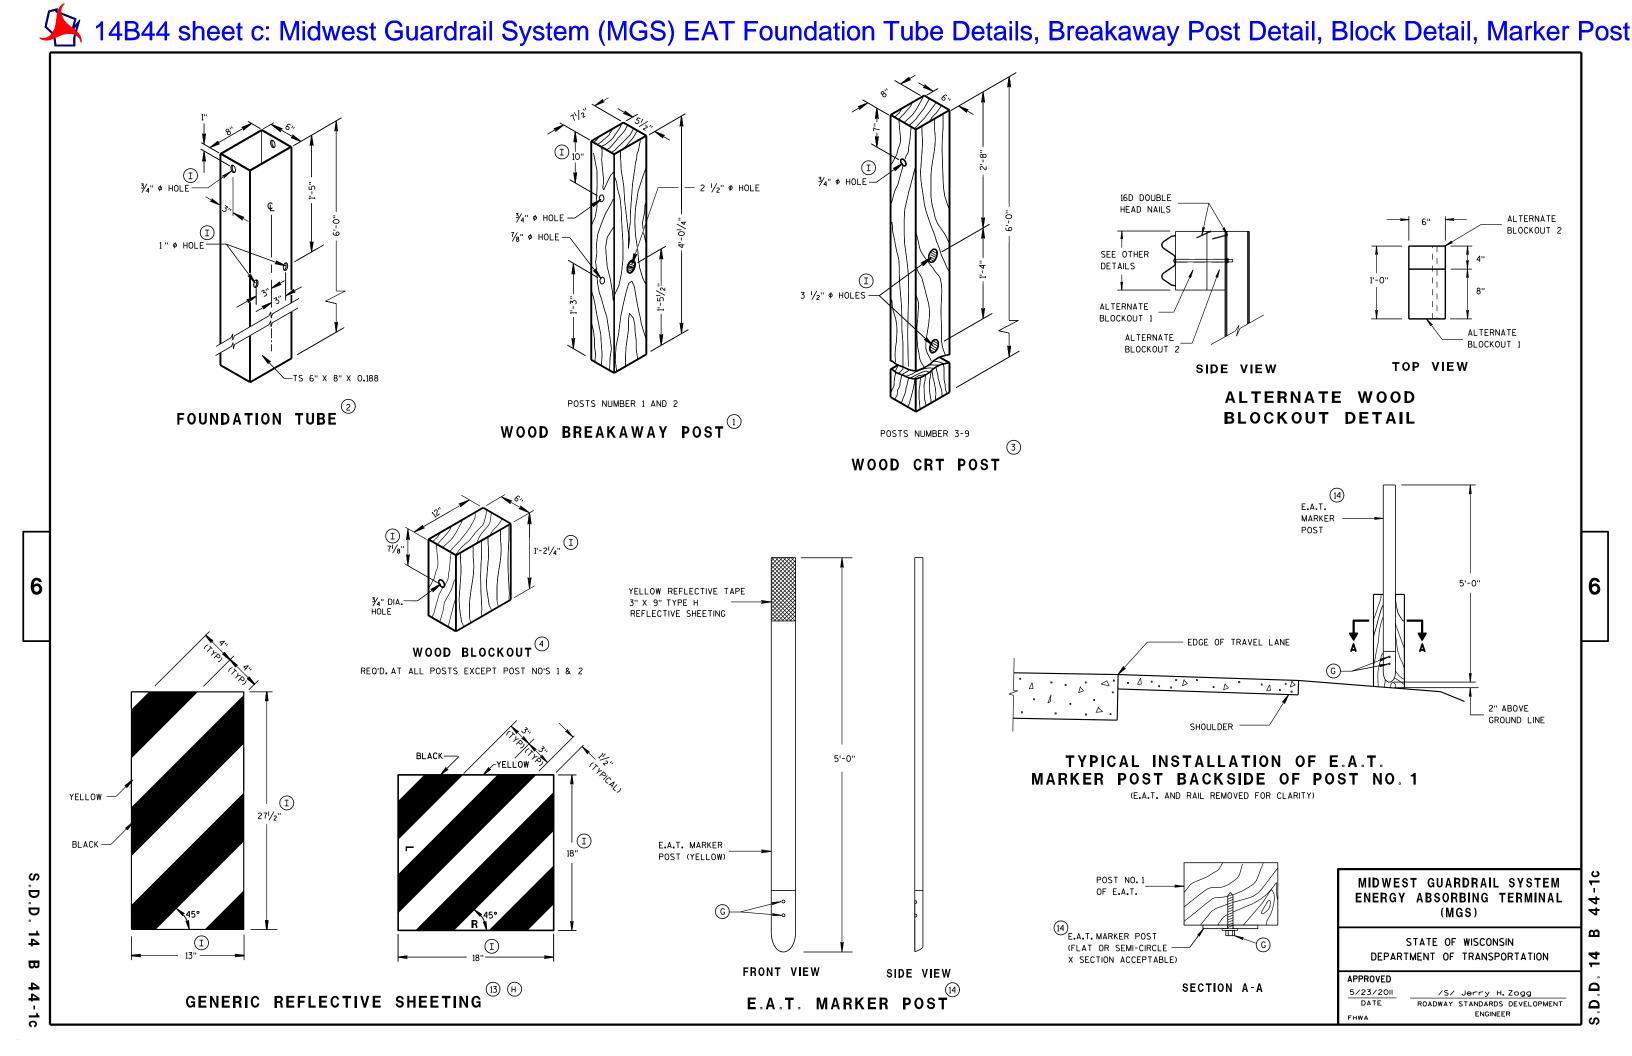

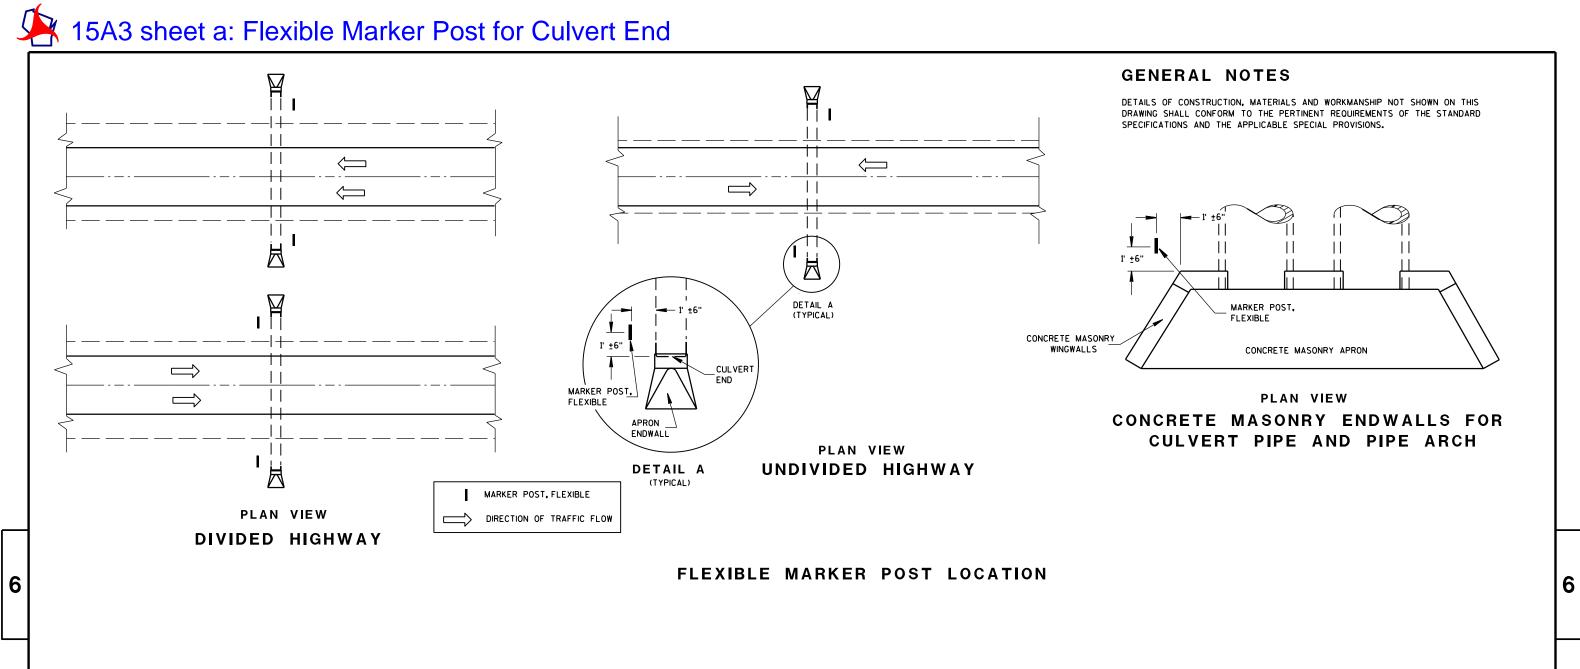

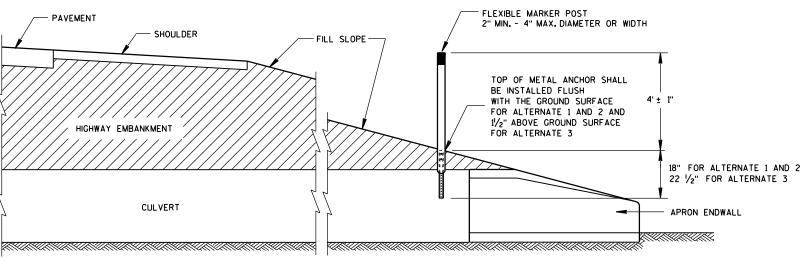

FLEXIBLE MARKER POST FOR CULVERT END

STATE OF WISCONSIN
DEPARTMENT OF TRANSPORTATION

က

15


۵


Ω

3.D.D. 15 A 3-2

FLEXIBLE MARKER POST

CROSS SECTION

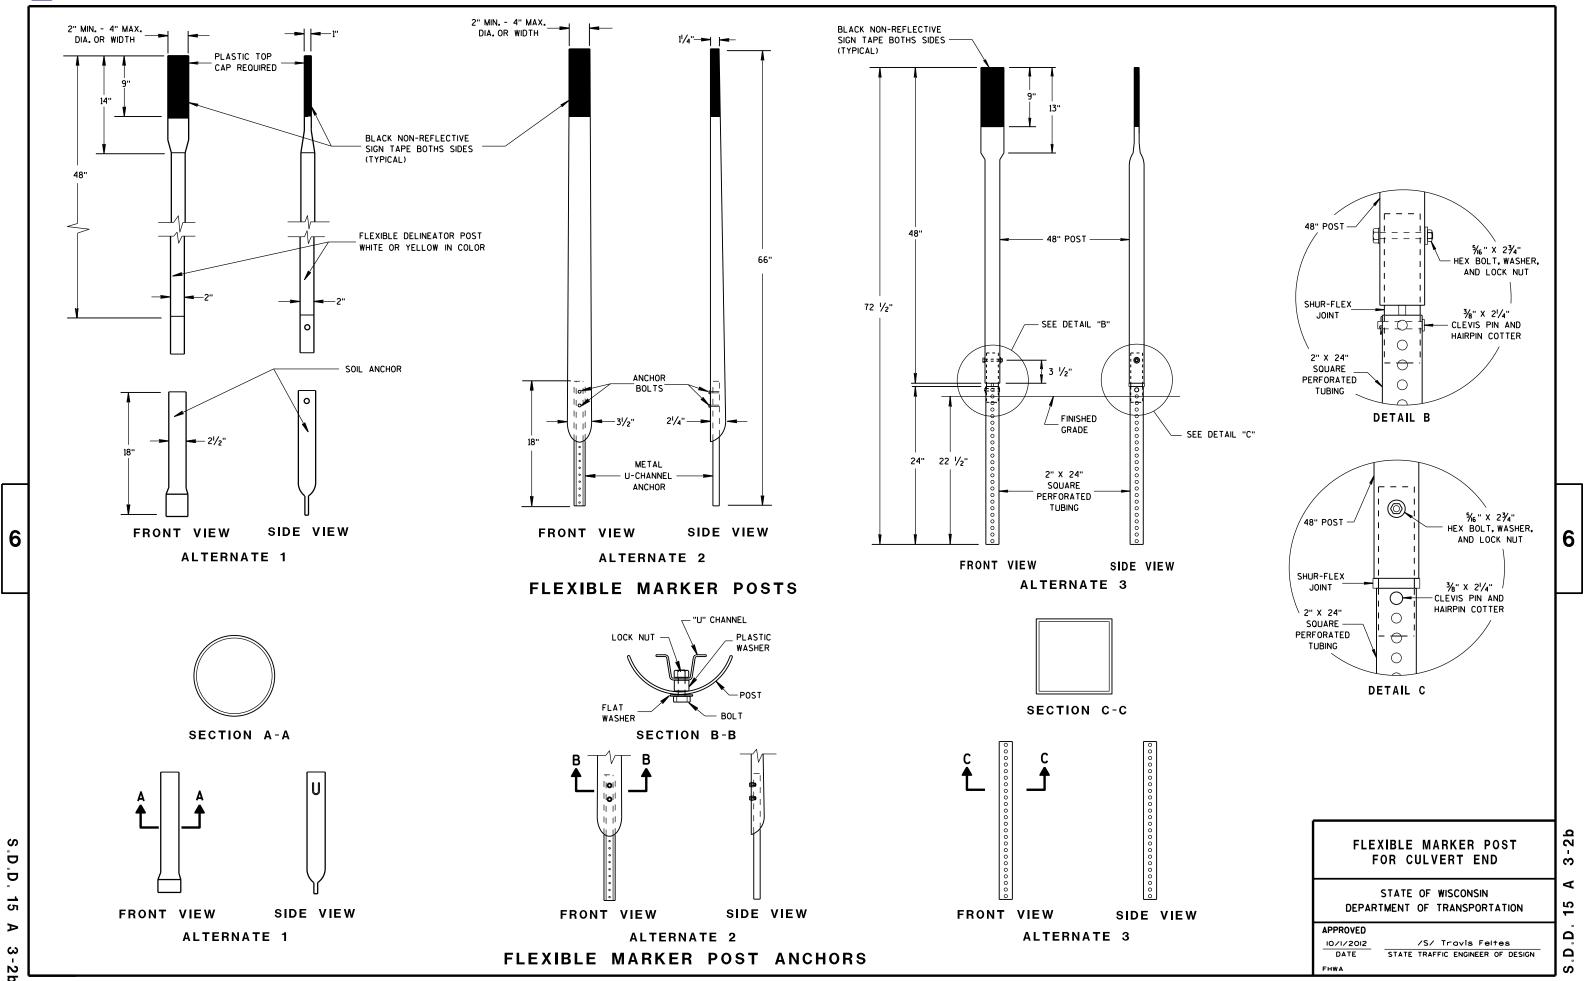

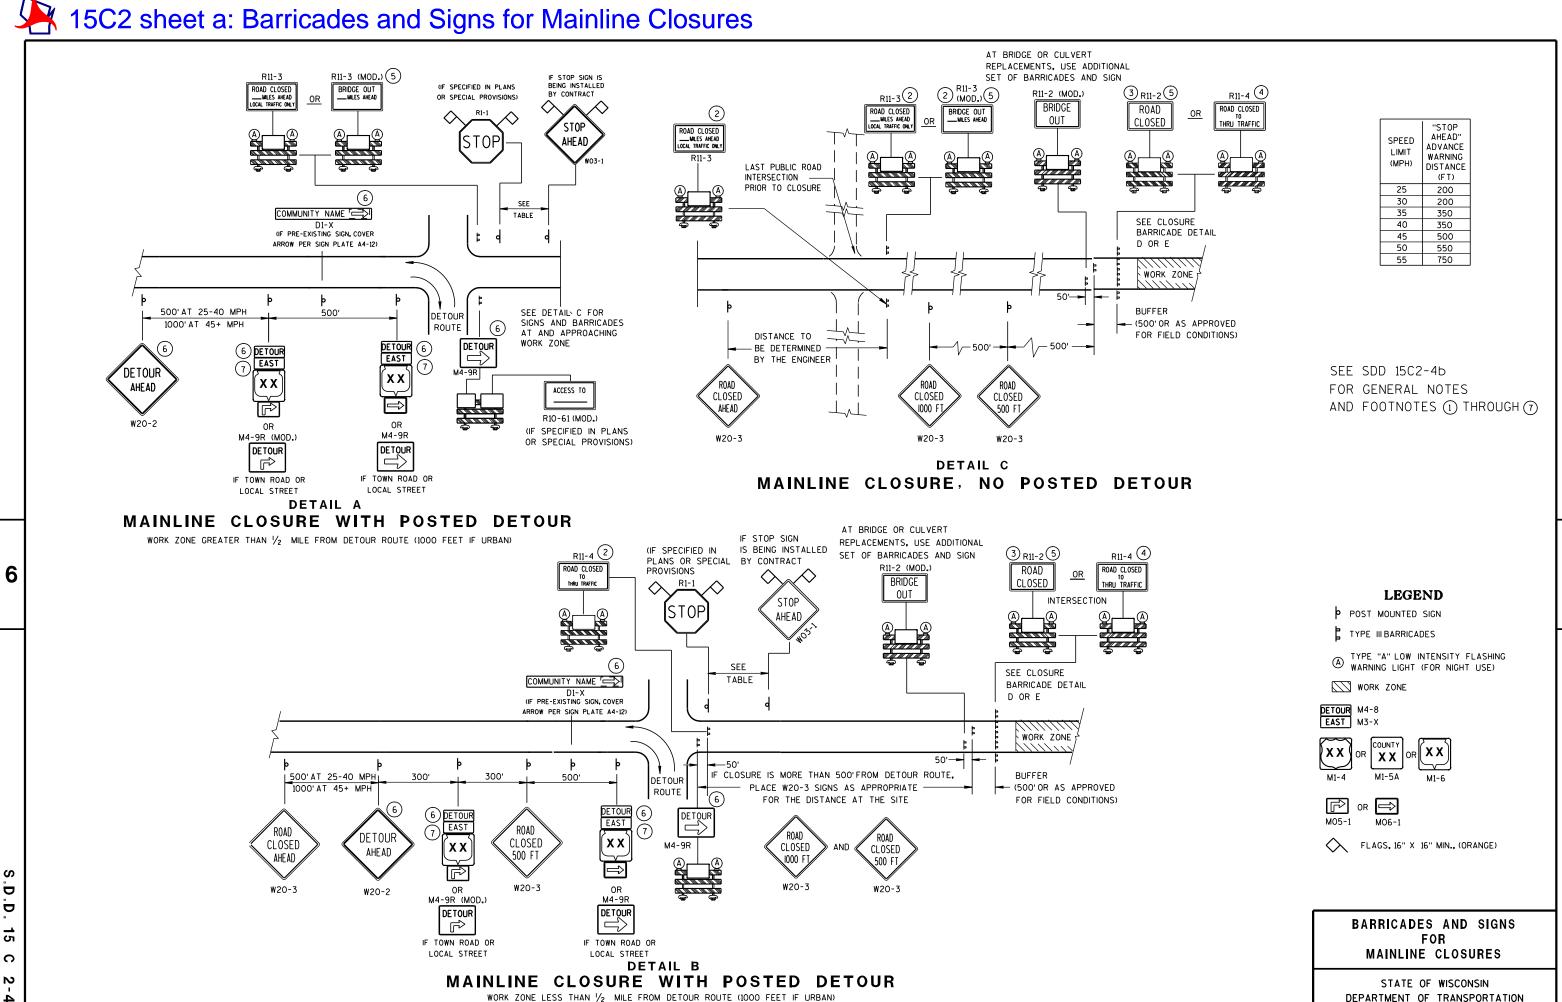

DEPARTMENT OF TRANSPORTATION

Ω Ω CLOSED

DETAIL D

ROAD CLOSURE BARRICADE DETAIL

APPROACH VIEW

DETAIL E

APPROACH VIEW

LANE CLOSURE BARRICADE DETAIL

BRIDGE

R11-2 (MOD.)

OUTSIDE EDGE OF SHOULDER

OR FACE OF CURB

ROAD CLOSED

THRU TRAFFIC

1)TWO-WAY

TYPE "A" WARNING

LIGHTS REQUIRED

OUTSIDE EDGE OF SHOULDER

OR FACE OF CURB

TWO-WAY

OFFSET BARRICADES 50' AS SHOWN ON DETAIL B

TYPE "A" WARNING-

LIGHTS REQUIRED

Ō

SEE SDD 15C2-4a FOR LEGEND

GENERAL NOTES

THE EXACT NUMBER, LOCATION, AND SPACING OF ALL SIGNS AND BARRICADES SHALL BE ADJUSTED TO FIT FIELD CONDITIONS AS APPROVED BY THE ENGINEER.

ANY SIGNS TEMPORARY OR EXISTING, WHICH CONFLICT WITH TRAFFIC CONTROL "IN USE" SHALL BE REMOVED OR COVERED AS NEEDED AND AS APPROVED BY THE ENGINEER.

THE SPACING BETWEEN TRAFFIC CONTROL SIGNS SHOULD BE ADJUSTED TO NOT CONFLICT WITH AND SHOULD PROVIDE A DESIRABLE MINIMUM OF 200 FEET CLEARANCE TO EXISTING SIGNS THAT WILL REMAIN IN PLACE.

BARRICADES THAT MUST BE MOVED FOR A WORK OPERATION SHALL BE IMMEDIATELY RE-ESTABLISHED UPON COMPLETION OF THE OPERATION OR, FOR CONTINUING OPERATIONS, AT THE END OF EACH WORKING DAY.

SIGNS THAT WILL BE IN PLACE LESS THAN 7 CONTINUOUS DAYS AND NIGHTS MAY BE MOUNTED ON PORTABLE SUPPORTS.

ALL TYPE III BARRICADES SHALL HAVE RAILS REFLECTORIZED ON BOTH FACES. STRIPES SHALL BE PROPERLY SLOPED DOWN TOWARD THE TRAFFIC SIDE OR AS SHOWN IN THE ROAD CLOSURE BARRICADE DETAIL D FOR FULL ROAD CLOSURES.

TYPE "A" LOW-INTENSITY FLASHING WARNING LIGHTS SHALL BE VISIBLE ON BOTH SIDES OF THE BARRICADE.

THE R11-2, R11-3, M4-9, R11-4 AND R10-61 SIGNS PLACED ON BARRICADES SHALL COVER NO MORE THAN THE TOP RAIL. THE SIGNS SHALL NOT COVER ANY PORTION OF THE MIDDLE OR BOTTOM RAILS.

THE REFLECTIVE SHEETING USED ON R11-2, R11-3, R11-4, R10-61 AND R1-1 SIGNS SHALL COMPLY WITH SUBSECTION 637.2.2.2 OF THE STANDARD SPECIFICATIONS.

"WO AND "MO" SIGNS ARE THE SAME AS "W" AND "M" SIGNS EXCEPT THE BACKGROUND IS ORANGE.

ALL SIGNS SHALL BE 48" X 48" UNLESS OTHERWISE NOTED BELOW:

R11-2 SHALL BE 48" X 30".

R11-3, R11-4 AND R10-61 SHALL BE 60" X 30".

M4-9 SHALL BE 30" X 24".

M3-X AND M4-8 SHALL BE 24" X 12" (30" X 15" IF NEEDED TO MATCH EXISTING SIGNS.) M1-4, M1-5A, AND M1-6 SHALL BE 24" X 24". (36" X 36" IF NEEDED TO MATCH EXISTING SIGNS.) MO5-1 AND MO6-1 SHALL BE 21" X 21". (30" X 30" IF NEEDED TO MATCH EXISTING SIGNS.)

D1-X SHALL BE AS SHOWN ON SPECIFIC PROJECT SIGNING DETAIL SHEETS.

R1-1 SHALL BE 36" X 36".

- (1) TWO WARNING LIGHTS SHALL BE PROVIDED ON THE CENTER BARRICADE AND A MINIMUM OF ONE WARNING LIGHT SHALL BE PROVIDED ON EACH OF THE OTHER BARRICADES WITHIN THE ROADWAY LIMITS. SPACING OF THE WARNING LIGHTS SHALL BE UNIFORM TO THE EDGE OF ROADWAY AS SHOWN (APPROX.8-FOOT
- THESE SIGNS AND BARRICADES ARE NOT REQUIRED IF ROAD CLOSURE BEGINS AT INTERSECTION.
- FOR ROAD CLOSURE WITHOUT LOCAL ACCESS TO PROJECT, SEE ROAD CLOSURE BARRICADE DETAIL D.
- FOR ROAD CLOSURE WITH LOCAL ACCESS TO PROJECT, SEE LANE CLOSURE BARRICADE DETAIL E.
- FOR BRIDGE OR CULVERT REPLACEMENTS, SUBSTITUTE "BRIDGE OUT" INSTEAD OF "ROAD CLOSED" ON R11-2 AND R11-3 SIGNS.
- INSTALL DETOUR AND COMMUNITY GUIDE SIGNS AND ARROWS ONLY IF SPECIFIED IN THE CONTRACT. IF THERE ARE EXISTING ROUTE MARKER ASSEMBLIES THAT WILL REMAIN IN PLACE, ADJUST THE LOCATION OF THE DETOUR ROUTE SIGNS TO CORRESPOND WITH THE EXISTING ASSEMBLIES. MODIFY EXISTING SIGNS WHERE POSSIBLE. SEE SPECIFIC PROJECT DETOUR SIGNING DETAIL SHEETS. IF DETOUR SIGNS ARE BEING INSTALLED BY OTHERS, PLACE THE CONTRACTED TRAFFIC CONTROL SIGNS TO ALLOW FOR PLACEMENT OF ALL WARNING, DETOUR AND GUIDE SIGNS AS SHOWN.
- "EAST" CARDINAL DIRECTION MARKERS AND RIGHT TURN ARROWS ARE SHOWN, USE OTHER CARDINAL DIRECTIONS AND ARROWS AS APPROPRIATE.

BARRICADES AND SIGNS MAINLINE CLOSURES

STATE OF WISCONSIN DEPARTMENT OF TRANSPORTATION

/S/ Thomas N. Notbohm
CHIEF SIGNS AND MARKING ENGINEER

Ω

APPROVED

6


D

D

15

C

15C3: Barricades and Signs for Sideroad Closures

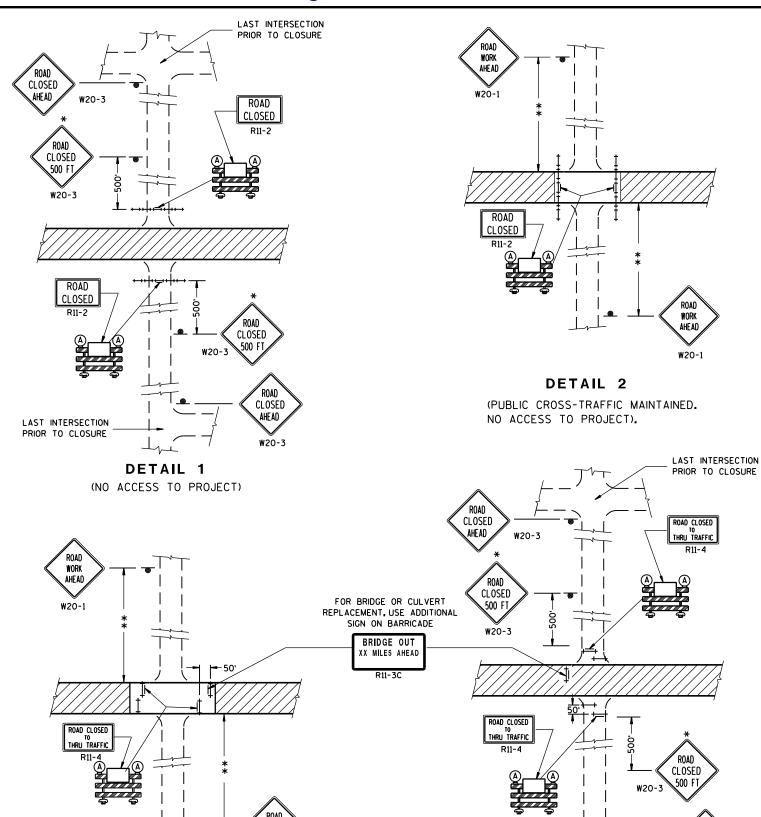

DETAIL 3

(PUBLIC CROSS-TRAFFIC MAINTAINED. CONTRACTOR, LOCAL BUSINESS AND RESIDENT ACCESS).

DETAIL 4 (CONTRACTOR, LOCAL BUSINESS AND RESIDENT ACCESS TO PROJECT)

LAST INTERSECTION

PRIOR TO CLOSURE

ROAD

CLOSED

W20-3

GENERAL NOTES

THE EXACT NUMBER, LOCATION, AND SPACING OF ALL SIGNS AND BARRICADES SHALL BE ADJUSTED TO FIT FIELD CONDITIONS AS APPROVED BY THE ENGINEER.

ANY SIGNS TEMPORARY OR EXISTING, WHICH CONFLICT WITH TRAFFIC CONTROL "IN USE" SHALL BE REMOVED OR COVERED AS NEEDED AND AS APPROVED BY THE ENGINEER.

THE SPACING BETWEEN TRAFFIC CONTROL SIGNS SHOULD BE ADJUSTED TO NOT CONFLICT WITH AND SHOULD PROVIDE A DESIRABLE MINIMUM OF 200 FEET CLEARANCE TO EXISTING SIGNS THAT WILL REMAIN IN PLACE.

IF A "STOP" SIGN MUST BE REMOVED FOR A WORK OPERATION, A TEMPORARY "STOP" SIGN SHALL BE PLACED PRIOR TO THE SIGN REMOVAL, OR A FLAGGER SHALL BE PROVIDED UNTIL THE SIGN IS

BARRICADES THAT MUST BE MOVED FOR A WORK OPERATION SHALL BE IMMEDIATELY RE-ESTABLISHED UPON COMPLETION OF THE OPERATION OR, FOR CONTINUING OPERATIONS, AT THE END OF EACH WORKING DAY. SIGNS THAT WILL BE IN PLACE LESS THAN 7 CONTINUOUS DAYS AND NIGHTS MAY BE MOUNTED ON

ALL TYPE III BARRICADES SHALL HAVE RAILS REFLECTORIZED ON BOTH FACES. STRIPES SHALL BE PROPERLY SLOPED DOWN TOWARD THE TRAFFIC SIDE OR AS SHOWN IN THE ROAD CLOSURE BARRICADE DETAIL D FOR FULL ROAD CLOSURES.

TYPE "A" LOW-INTENSITY FLASHING WARNING LIGHTS SHALL BE VISIBLE ON BOTH SIDES OF THE

THE R11-2, R11-3 AND R11-4 SIGNS PLACED ON BARRICADES SHALL COVER NO MORE THAN THE TOP RAIL. THE SIGNS SHALL NOT COVER ANY PORTION OF THE MIDDLE OR BOTTOM RAILS.

ALL SIGNS SHALL BE 48" X 48" UNLESS OTHERWISE NOTED BELOW: R11-2 SHALL BE 48" X 30". R11-4 AND R11-3 SHALL BE 60" X 30".

> *OMIT THE "ROAD CLOSED 500 FT." SIGN IF THE LAST INTERSECTION IS 500 FT. OR LESS FROM THE WORK ZONE.

**500'MAX. OR AT LAST INTERSECTION WHICHEVER IS CLOSER.

LEGEND

SIGN ON PERMANENT SUPPORT

TYPE III BARRICADE

TYPE III BARRICADE WITH ATTACHED SIGN


(A) TYPE "A" WARNING LIGHT (FLASHING)

BARRICADES AND SIGNS FOR SIDEROAD CLOSURES

STATE OF WISCONSIN DEPARTMENT OF TRANSPORTATION

/S/ Travis Feltes STATE TRAFFIC ENGINEER OF DESIGN

က Ω

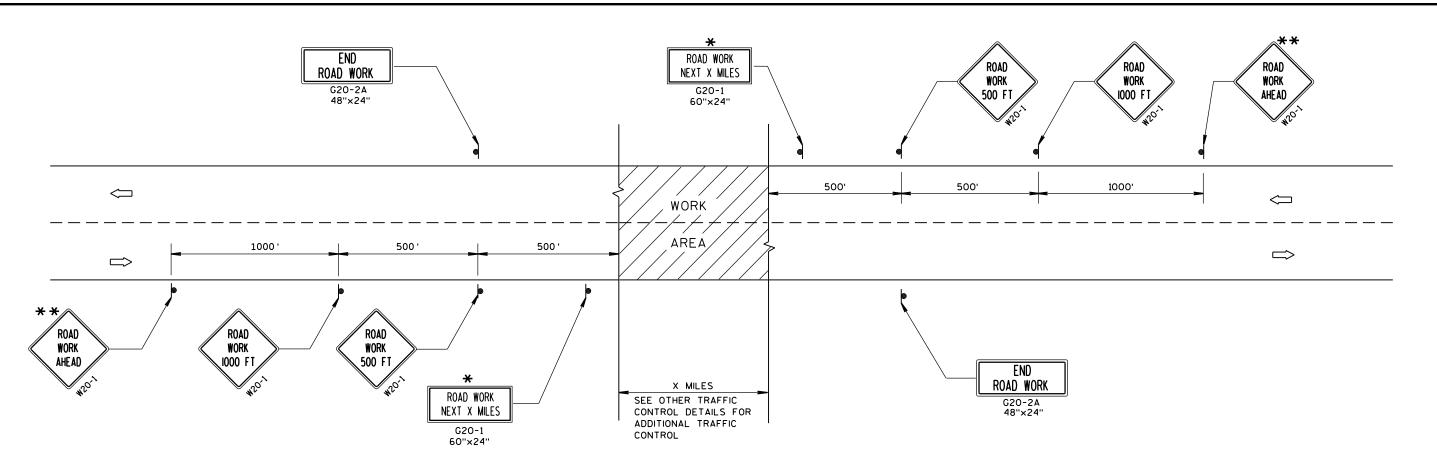

TYPICAL SIDEROAD APPROACH WARNING SIGN DETAIL

GENERAL NOTES

THE EXACT NUMBER, LOCATION, AND SPACING OF ALL SIGNS AND DEVICES SHALL BE ADJUSTED TO FIT FIELD CONDITIONS.


THE SPACING BETWEEN TRAFFIC CONTROL SIGNS SHOULD BE ADJUSTED TO NOT CONFLICT WITH AND SHOULD PROVIDE A MINIMUM OF 200 FEET (500 FEET DESIRABLE) CLEARANCE TO EXISTING SIGNS THAT WILL REMAIN IN PLACE.

ALL SIGNS ARE 48"x48" UNLESS OTHERWISE NOTED.

SIGNS THAT WILL BE IN PLACE LESS THAN 7 CONTINUOUS DAYS AND NIGHTS MAY BE MOUNTED ON PORTABLE SUPPORTS.

IF A "STOP" SIGN MUST BE REMOVED FOR A WORK OPERATION, A TEMPORARY "STOP" SIGN SHALL BE PLACED PRIOR TO THE SIGN REMOVAL, OR A FLAGGER SHALL BE PROVIDED UNTIL THE SIGN IS RE-ESTABLISHED.


- * OMIT G20-1 SIGNS IF LENGTH OF WORK AREA IS 2 MILES OR LESS.
- * PLACE ADDITIONAL W20-1 "ROAD WORK AHEAD" SIGN IF WORK AREA WITHIN THE PROJECT IS SEPARATED BY MORE THAN 2 MILES FROM PREVIOUS WORK AREA.

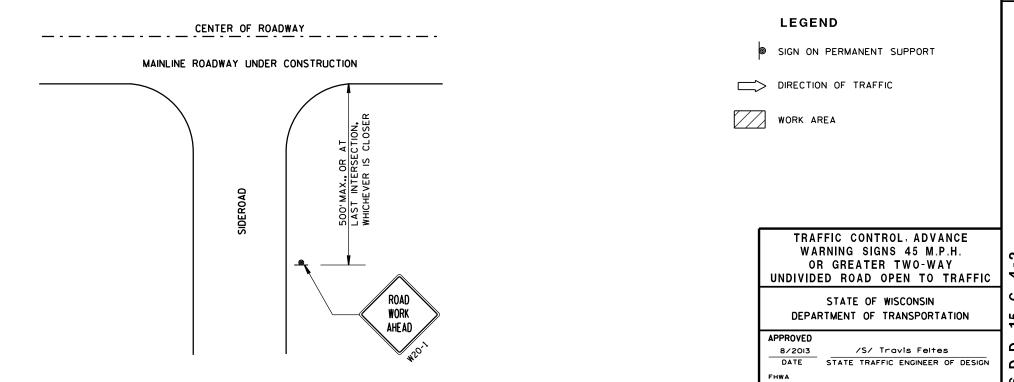

D

D

6

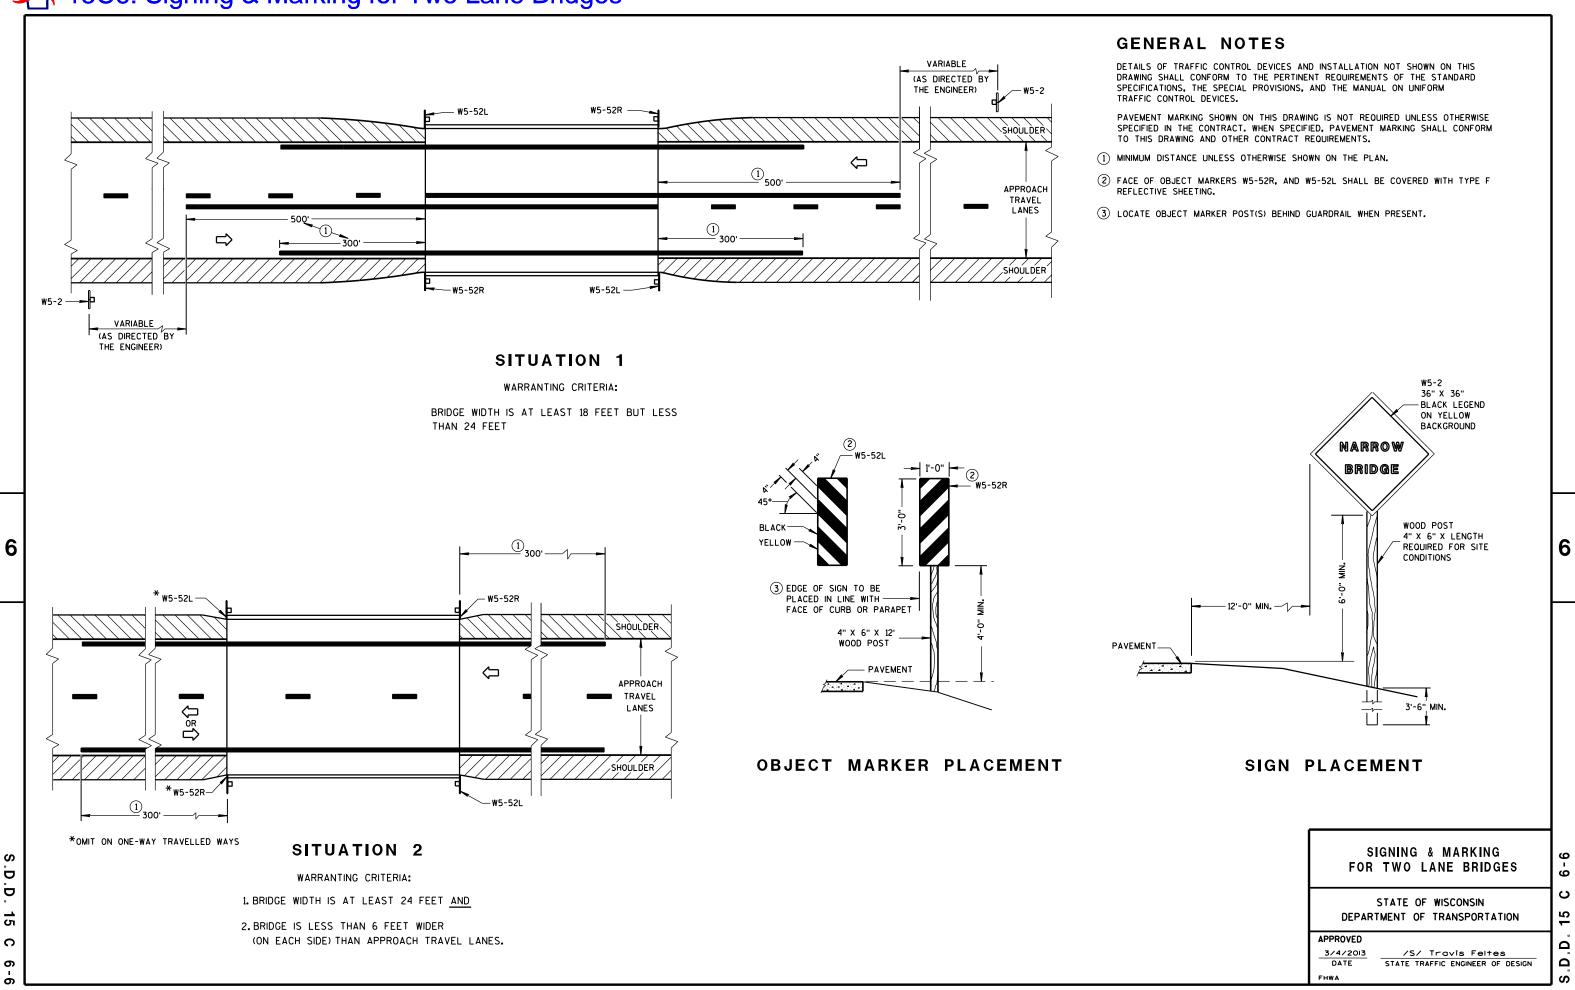


15C8 sheet a: Pavement Marking (Mainline)

6


Ö

D

15

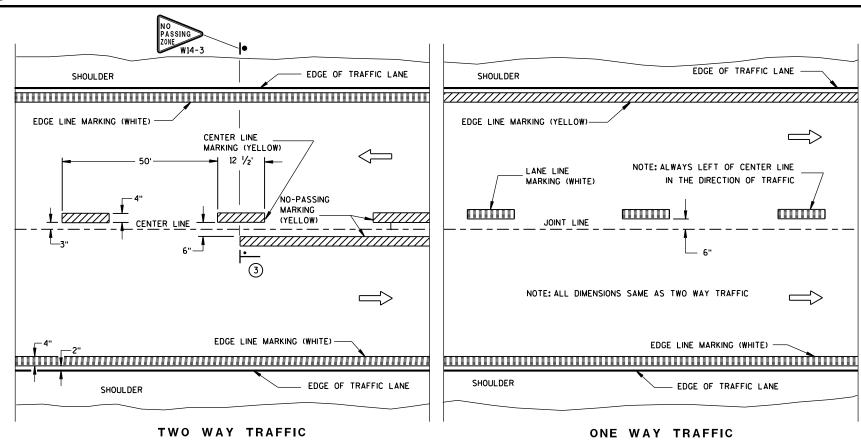

PERMANENT PAVEMENT MARKING

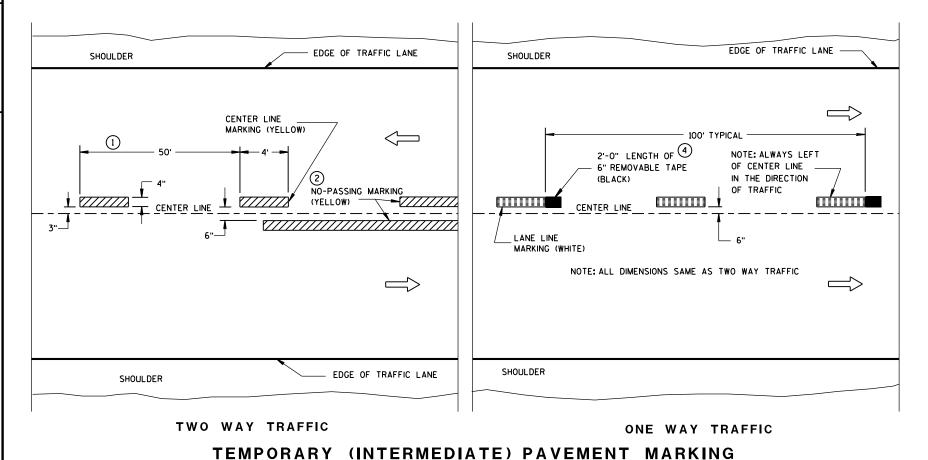

(SHOWS CYCLE FOR TEMPORARY CENTER LINE OR TEMPORARY LANE LINE MARKING)


GENERAL NOTES

DETAILS OF CONSTRUCTION NOT SHOWN ON THIS DRAWING SHALL CONFORM TO STANDARD SPECIFICATIONS AND SPECIAL PROVISIONS.


- 1 HALF CYCLE LENGTHS (25'±) WITH 2' MINIMUM STRIPE LENGTHS SHALL BE PROVIDED ON ROADWAYS (INCLUDING TEMPORARY TRAVELED WAYS) WITH REVERSE CURVATURE, CURVATURE OF OVER 5 DEGREES OR WHEN DIRECTED BY THE ENGINEER TO MARK UNUSUAL ALIGNMENT OF THE TRAVELED WAY.
- 2 NO PASSING ZONE TEMPORARY PAVEMENT MARKING IS REQUIRED TO BE PLACED, WHERE APPROPRIATE, ALONG WITH CENTERLINE TEMPORARY PAVEMENT MARKING WHEN A SAME DAY PERMANENT PAVEMENT MARKING ITEM IS INCLUDED IN THE CONTRACT.
- (3) NO PASSING ZONE MARKINGS ARE PLACED ACCORDING TO "T" MARKINGS. IF EXISTING NO PASSING ZONE W14-3 SIGNS ARE BEYOND 50 FEET IN EITHER DIRECTION, THE SIGNS SHALL BE MOVED TO THE "T" MARKINGS.
- (4) CONCRETE ONLY.

NOTE


ARROW SYMBOL () SHOWS DIRECTION OF TRAVEL

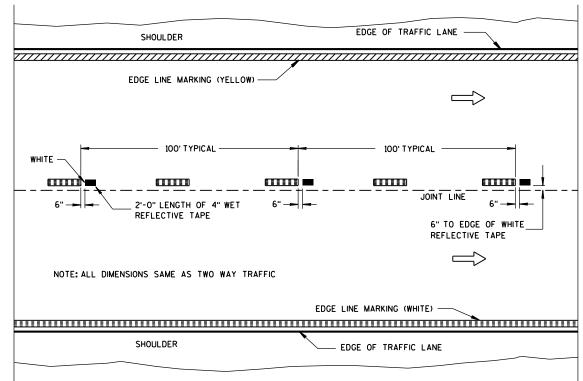

WET REFLECTIVE TAPE SUPPLEMENT TO SPRAYED OR NON WET REFLECTIVE TAPE LANE LINE

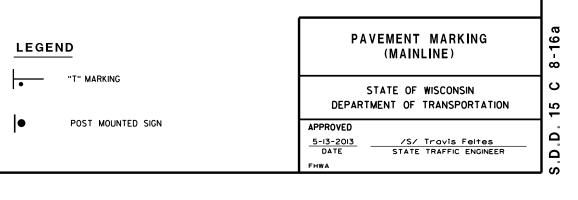

15C8 sheet b: Pavement Marking (Intersections) **GENERAL NOTES** EDGE LINE MARKING EDGE LINES SHALL BE OMITTED THROUGH INTERSECTIONS. EDGE LINES SHALL BE (5) BARRIER LINE ENDS AT SIDE ROAD PAVEMENT/SURFACE EDGE EXTENSION. CONTINUED THROUGH DRIVEWAYS. (6) BARRIER LINE STARTS 500 FEET PRIOR TO THE BYPASS TAPER. 1) WHEN DISTANCE "A" IS LESS THAN 250 FEET, OMIT LANE LINE. (2) WHEN DISTANCE "B" IS LESS THAN 100 FEET, OMIT CHANNELIZING LANE LINE. (7) IF THE DISTANCE BETWEEN 2 SUCCESSIVE NO-PASSING ZONES IS LESS THAN THE MINIMUM DISTANCE BETWEEN ZONES, CONNECT THE 2 ZONES. (3) ALTERNATIVE MARKING SHALL BE PROVIDED WHEN SPECIFIED IN THE CONTRACT. 8 3' LINE 9' GAP, EXCEPT RETRACE THE EXISTING LINE - GAP PATTERN TYPICAL SITUATIONS WHERE THIS MARKING MAY BE REQUIRED ARE WHERE THE WHERE EXISTING MARKINGS ARE IN PLACE. INTERSECTION IS ON A SHARP HORIZONTAL CURVE OR CREST VERTICAL CURVE IN AN UNLIGHTED AREA SUCH THAT THE EDGE LINE MAY BE MISLEADING TO THE MOTORIST END MARKING WHERE-OR DISAPPEAR FROM SIGHT. CORNER RADIUS BEGINS ARROW SYMBOL (>>) SHOWS DIRECTION OF TRAVEL 4) THE EDGE LINE IN THE TAPER AREAS OF THE BYPASS LANE AND THE BYPASS LANE SHALL BE LOCATED 1-FOOT FROM EDGE OF PAVEMENT TO THE OUTSIDE EDGE OF EDGE LINE. END MARKING AT P.C. OR END OF CURB & GUTTER CHANNELIZING MINOR INTERSECTION WITHOUT CURBS LANE LINE 8" (WHITE) RIGHT TURN LANE **EIIIIIIII** CENTER LINE MARKING-MINIMUM DISTANCE POSTED SPEED **⊸**6) **BETWEEN ZONES** EDGE LINE (MPH) (FEET) \Longrightarrow 500 25 - 30 35 - 40 528 45 - 50 - EDGE LINÈ 55 792 BYPASS LANE PAVED SHOULDER WIDTH (AS SHOWN ELSEWHERE IN PLANS) - PLUS 2 INCHES **MAJOR INTERSECTIONS** 6

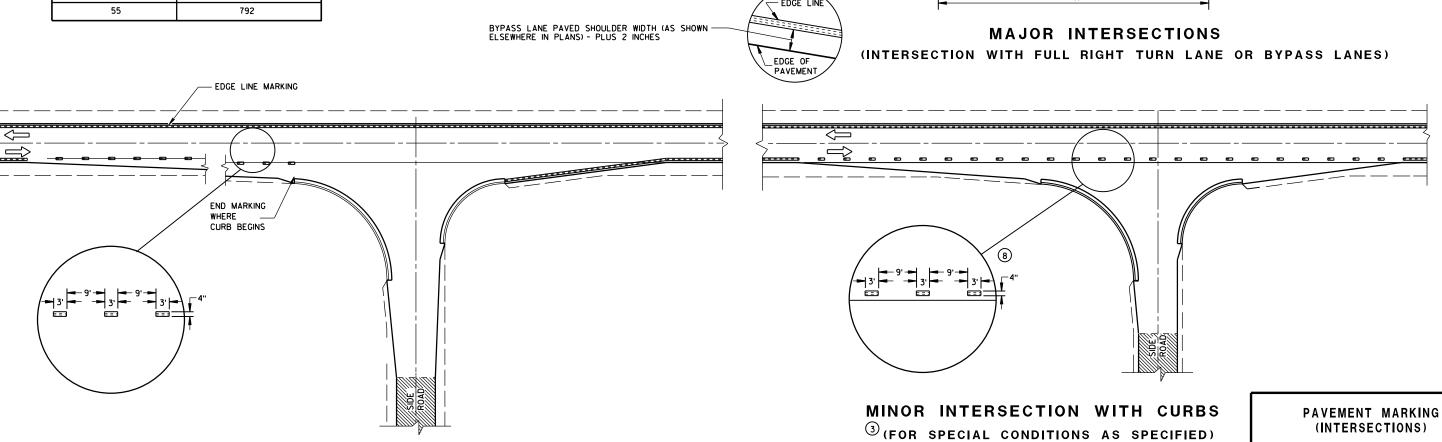

MINOR INTERSECTION WITH CURBS

(TYPICAL MARKING)

D D

15

EDGE LINE

MARKING

EDGE LINE


8-16b

Ω

Ω

STATE OF WISCONSIN

DEPARTMENT OF TRANSPORTATION

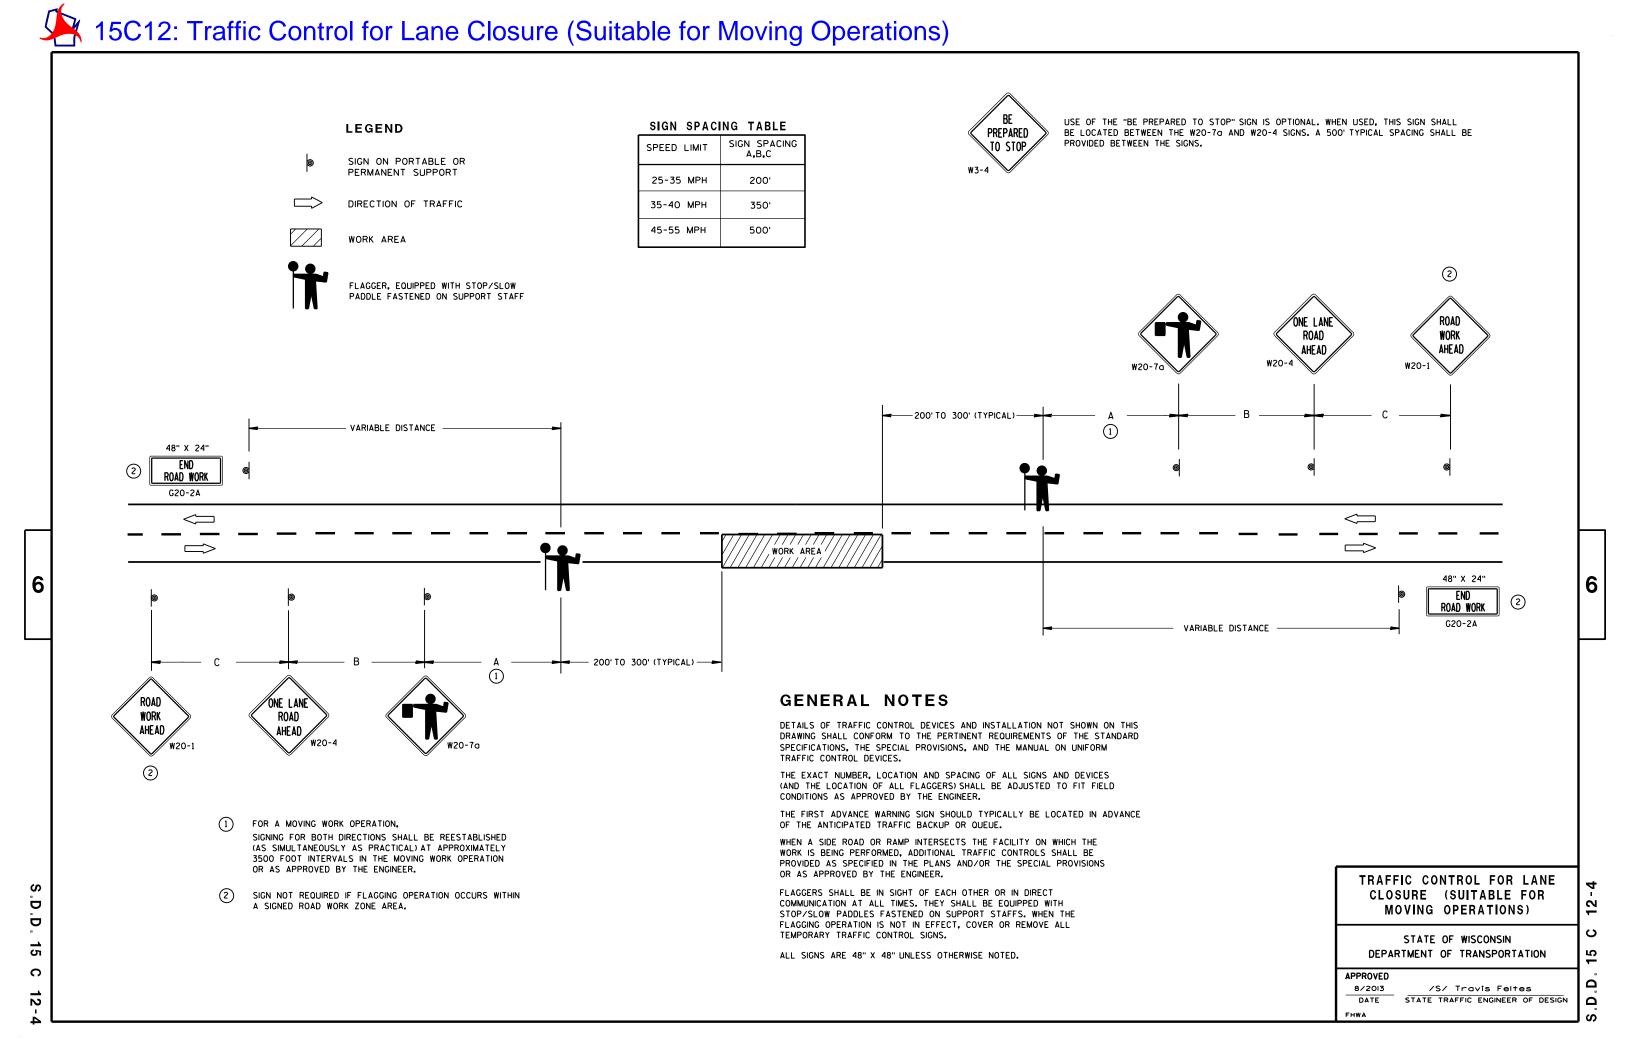

6

b

D

C

19

S.D.D. 15 C 19-2a

/S/ Travis Feltes
STATE TRAFFIC ENGINEER


APPROVED

FHWA

- 1. Sign is Type II Type F Reflective reference WIS DOT Standard Specification for HIGHWAY and STRUCTURE CONSTRUCTION latest edition.
- 2. Color:

Background - Orange Message - Black

- 3. Message Series C
- 4. Corners may be square or rounded when base material is plywood but borders shall be rounded as shown. When base material is metal, the corners and borders shall be rounded.
- 5. Substitute appropriate numerals and optically adjust spacing to achieve proper balance

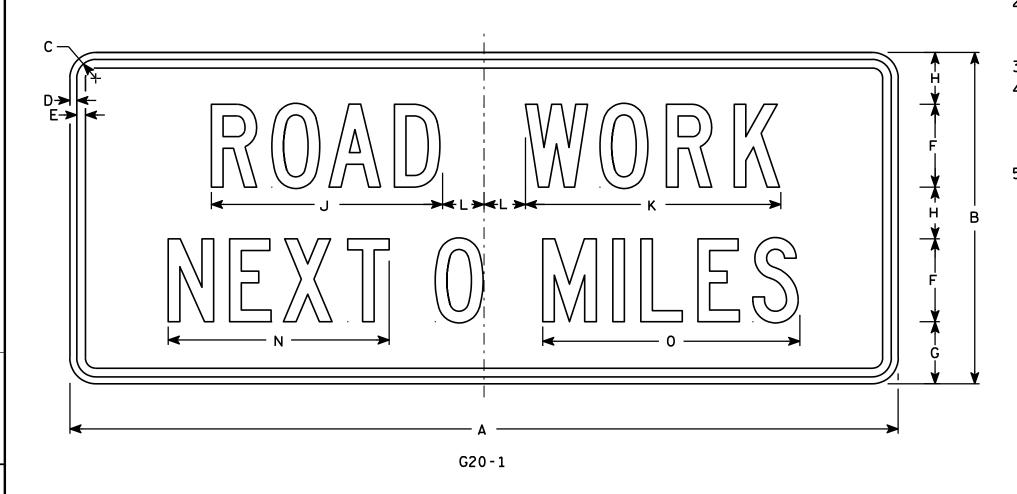

Metric equivalent for this sign is:

PROJECT NO:

1 2 1500 mm x 600 mm 3 4 1500 mm x 600 mm

SIZE	Α	В	C	D	E	F	G	Н	I	J	K	L	M	N	0	Р	0	R	S	T	U	٧	W	X	Y	Z	sq. ft.	m2
1																												
2	60	24	1 3/8	1/2	5/8	6	4 1/2	3 3/4		16 3/4	18 1/2	3		16	18 5/8												10	.90
3																												
4	60	24	1 3/8	1/2	5/8	6	4 1/2	3 3/4		16 3/4	18 1/2	3		16	18 5/8												10	.90
5	·					·																						

COUNTY:

STANDARD SIGN G20-1

WISCONSIN DEPT OF TRANSPORTATION

APPROVED

Charte J Spens
for State Traffic Enginee

DATE 4/8/97 PLATE NO. G20-1.7

SHEET NO:

HWY:


PLOT NAME :

1. Sign is Type II - Type F Reflective - reference WIS DOT Standard Specification for HIGHWAY and STRUCTURE CONSTRUCTION latest edition.

2. Color:

Background - Orange Message - Black

- 3. Message Series C
- 4. Corners may be square or rounded when base material is plywood but borders shall be rounded as shown. When base material is metal, the corners and borders shall be rounded.

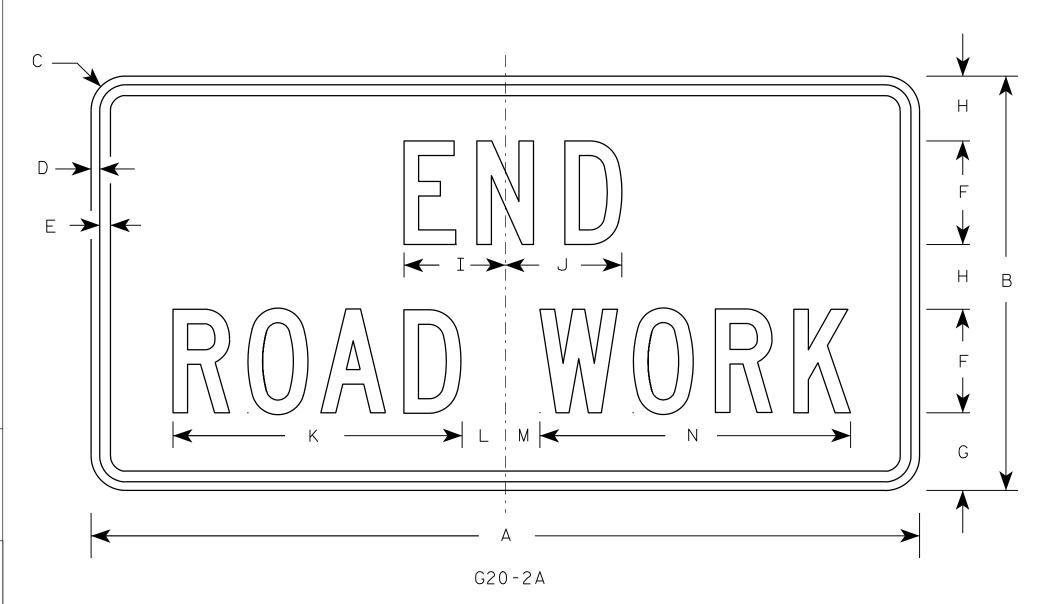

Metric equivalent for this sign is:

1 900 mm X 450 mm 1200 mm X 600 mm 3 1200 mm x 600 mm 1200 mm X 600 mm 5 1200 mm x 600 mm

SIZE	Α	В	С	D	E	F	G	Н	I	J	К	L	М	N	0	Р	Q	R	S	Т	U	٧	W	Х	Y	Z	Area sq. ft.	Area m2
1	36	18	1 1/8	3/8	1/2	4	3 3/4	2 1/2	4 1/8	4 1/8	11 1/8	2	1	12 1/8													4.5	0.41
2	48	24	1 1/2	1/2	5/8	6	4 1/2	3 3/4	5 %	6 3/4	16 ¾	2 1/2	1 3/4	18 ½													8.0	0.72
3	48	24	1 1/2	1/2	5/8	6	4 1/2	3 3/4	5 %	6 3/4	16 ¾	2 1/2	1 3/4	18 ½													8.0	0.72
4	48	24	1 1/2	1/2	5/8	6	4 1/2	3 3/4	5 %	6 3/4	16 ¾	2 1/2	1 3/4	18 ½													8.0	0.72
5	48	24	1 1/2	1/2	5/8	6	4 1/2	3 3/4	5 1/8	6 3/4	16 ¾	2 1/2	1 3/4	18 ½													8.0	0.72

COUNTY:

STANDARD SIGN G20-2A

WISCONSIN DEPT OF TRANSPORTATION

APPROVED For State Traffic Engineer PLATE NO. G20-2A.8

DATE 9/30/09

SHEET NO:

FILE NAME : C:\Users\PROJECTS\tr_stdplate\G202A.DGN

HWY:

PROJECT NO:


PLOT DATE: 30-SEP-2009 09:31

PLOT NAME :

PLOT BY : ditjph

PLOT SCALE: 5.561773:1.000000

WISDOT/CADDS SHEET 42

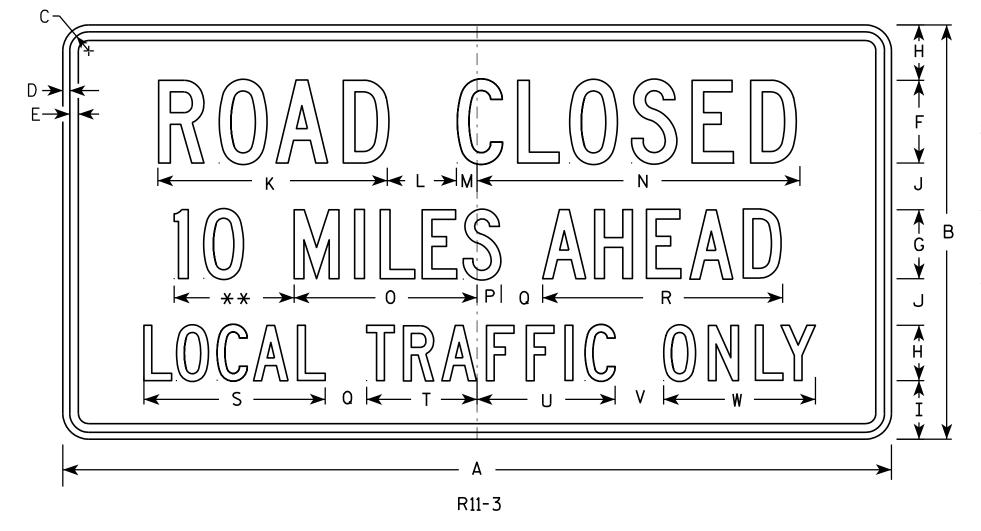

- 1. Sign is Type II Type H Reflective reference WIS DOT Standard Specification for HIGHWAY and STRUCTURE CONSTRUCTION latest edition.
- 2. Color:

Background - White Message - Black

- 3. Message Series C
- 4. Corners may be square or rounded when base material is plywood but borders shall be rounded as shown. When base material is metal, the corners and borders shall be rounded.
- 5. Substitute appropriate numerals and optically adjust spacing to achieve proper balance.

** See Note 5

SIZE	Α	В	С	D	Ε	F	G	Н	I	J	К	L	М	N	0	Р	0	R	S	T	U	V	W	X	Y	Z	Areg
1	36	18	1 3/8	1/2	5/8	4	3	2 1/2	2	2	11 1/8	3	1 1/8	15 1/4	8	1 1/2	2	10 ¾	8 3/8	4 3/4	6 1/2	2	6 ¾				4.5
25	60	30	1 3/8	1/2	5/8	6	5	4	4 1/4	3 3/8	16 %	5	1 1/2	23	13 1/4	1 3/4	3	17 3/8	13 1/8	8	10	3 1/2	11				12.5
2M	60	30	1 3/8	1/2	5/8	6	5	4	4 1/4	3 3/8	16 %	5	1 1/2	23	13 1/4	1 3/4	3	17 3/8	13 1/8	8	10	3 1/2	11				12.5
3																											
4																											
5																											

COUNTY:

STANDARD SIGN R11-3

WISCONSIN DEPT OF TRANSPORTATION

APPROVED Matthew & Rauch
For State Traffic Engineer

DATE 4/1/11 PLATE NO. R11-3.6

SHEET NO:

FILE NAME : C:\Users\PROJECTS\tr_stdplate\R113.DGN

HWY:

PROJECT NO:

PLOT DATE: 01-APR-2011 14:20

PLOT NAME :

PLOT BY: mscj9h


PLOT SCALE: 6.952216:1.000000

WISDOT/CADDS SHEET 42

- 1. Sign is Type II Type H Reflective reference WIS DOT Standard Specification for HIGHWAY and STRUCTURE CONSTRUCTION latest edition.
- 2. Color:

Background - White Message - Black

- 3. Message Series C
- 4. Corners may be square or rounded when base material is plywood but borders shall be rounded as shown. When base material is metal, the corners and borders shall be rounded.

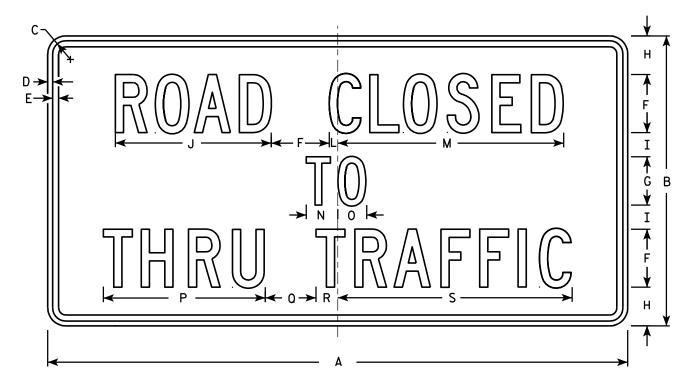

R11-4

SIZE	۸	В	<u> </u>	D	F	F	G	Н	т т		К	1	М	N	0	Гр	0	R	_ c	т	U	v	w	х	V	7	Area sq. ft.
1	-	-	·		_	•		••			- '`	_		- '		-	 	, n		•		•	-"				SQ. TT.
1																											
25	60	30	1 3/8	1/2	5/8	6	5	4	2 1/2	16 1/8		7∕8	23 ¾	3 1/4	3	16 3/4	5 1/4	2 1/4	24 1/4								12.5
2M	60	30	1 3/8	1/2	5/8	6	5	4	2 1/2	16 1/8		7 /8	23 ¾	3 1/4	3	16 3/4	5 1/4	2 1/4	24 1/4								12.5
3																											
4																											
5																											

STANDARD SIGN R11 - 4

WISCONSIN DEPT OF TRANSPORTATION

APPROVED

Matthew R Lawl

For State Traffic Engineer

DATE 4/1/11 PLATE NO. R11-4.3

SHEET NO:

HWY:

COUNTY:


PLOT NAME :

PLOT SCALE: 9.931739:1.000000

FILE NAME : C:\Users\PROJECTS\tr_stdplate\R114.DGN

PROJECT NO:

PLOT DATE: 01-APR-2011 14:11 PLOT BY: mscj9h

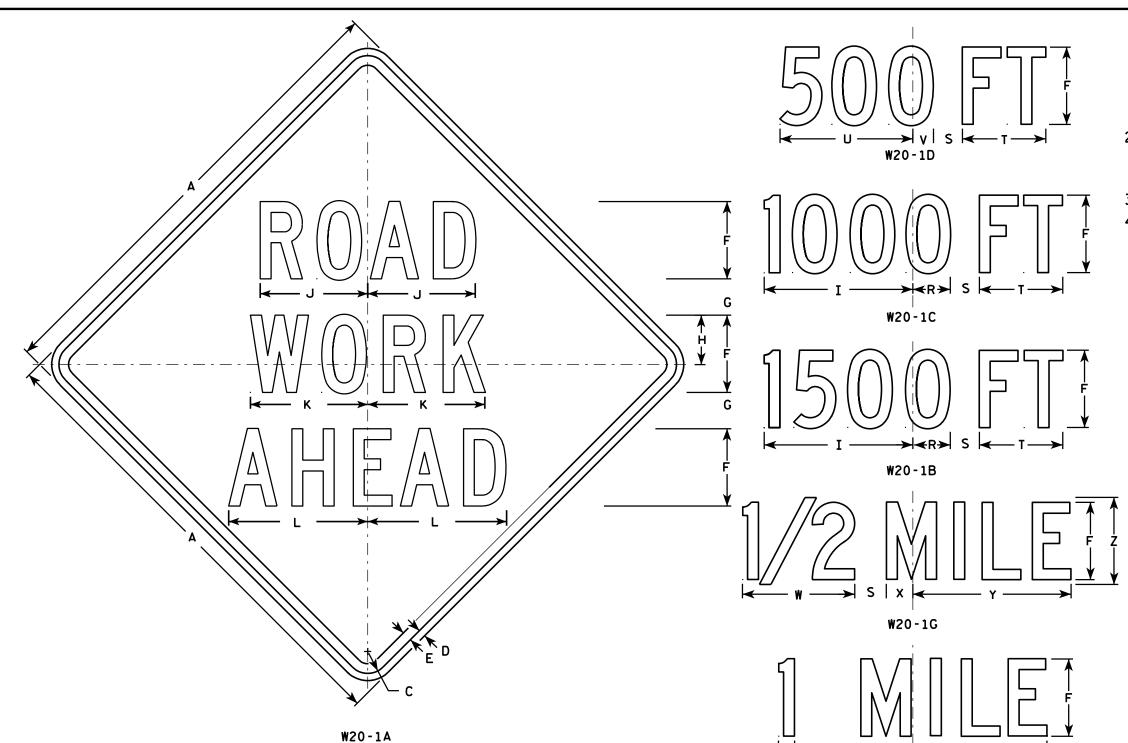

- 1. Sign is Type II Type F Reflective reference WIS DOT Standard Specification for HIGHWAY and STRUCTURE CONSTRUCTION latest edition.
- 2. Color:

Background - Orange Message - Black

- 3. Message Series C
- 4. Corners may be square or rounded when base material is plywood but borders shall be rounded as shown. When base material is metal, the corners and borders shall be rounded.

W20-1F

SIZE	Α	В	С	D	E	F	G	Н	I	J	K	L	М	N	0	Р	0	R	S	Т	U	V	W	X	Y	Z	Area sq. ft.
1	36		1 3/8	1/2	5/8	5	2 %	3 1/4	10 1/8	7	7 5/8	8 %	1 1/8	4 1/2	3 1/2	9		2 1/2	1 1/8	5 %	9	1 3/8	8	1 3/4	10 3/4	6	9.0
2S	48		2 1/4	3/4	1	8	3 3/4	5 1/8	15 3/8	11 1/8	12 1/8	14 3/8	1 5/8	6 1/8	5 3/8	13 %		3 %	3	8 %	13 ¾	2 1/8	11 1/8	2 3/4	16 3/8	9	16.0
2M	48		2 1/4	3/4	1	8	3 3/4	5 1/8	15 3/8	11 1/8	12 1/8	14 3/8	1 5/8	6 1/8	5 3/8	13 %		3 %	3	8 %	13 ¾	2 1/8	11 1/8	2 3/4	16 3/8	9	16.0
3	48		2 1/4	3/4	1	8	3 3/4	5 1/8	15 3/8	11 1/8	12 1/8	14 3/8	1 5/8	6 1/8	5 3/8	13 %		3 %	3	8 %	13 ¾	2 1/8	11 1/8	2 3/4	16 3/8	9	16.0
4	48		2 1/4	3/4	1	8	3 3/4	5 1/8	15 3/8	11 1/8	12 1/8	14 3/8	1 5/8	6 1/8	5 3/8	13 %		3 %	3	8 %	13 ¾	2 1/8	11 1/8	2 3/4	16 3/8	9	16.0
5	48		2 1/4	3/4	1	8	3 3/4	5 1/8	15 3/8	11 1/8	12 1/8	14 3/8	1 5/8	6 1/8	5 3/8	13 %		3 %	3	8 %	13 ¾	2 1/8	11 1/8	2 3/4	16 3/8	9	16.0
	•	•		,		•				•			,	•	•		•		,		•		,	•			


STANDARD SIGN W20-1A, B, C, D, F & G

WISCONSIN DEPT OF TRANSPORTATION

APPROVED DATE 3/18/11 PLATE NO. W20-1.9

SHEET NO:

PROJECT NO:

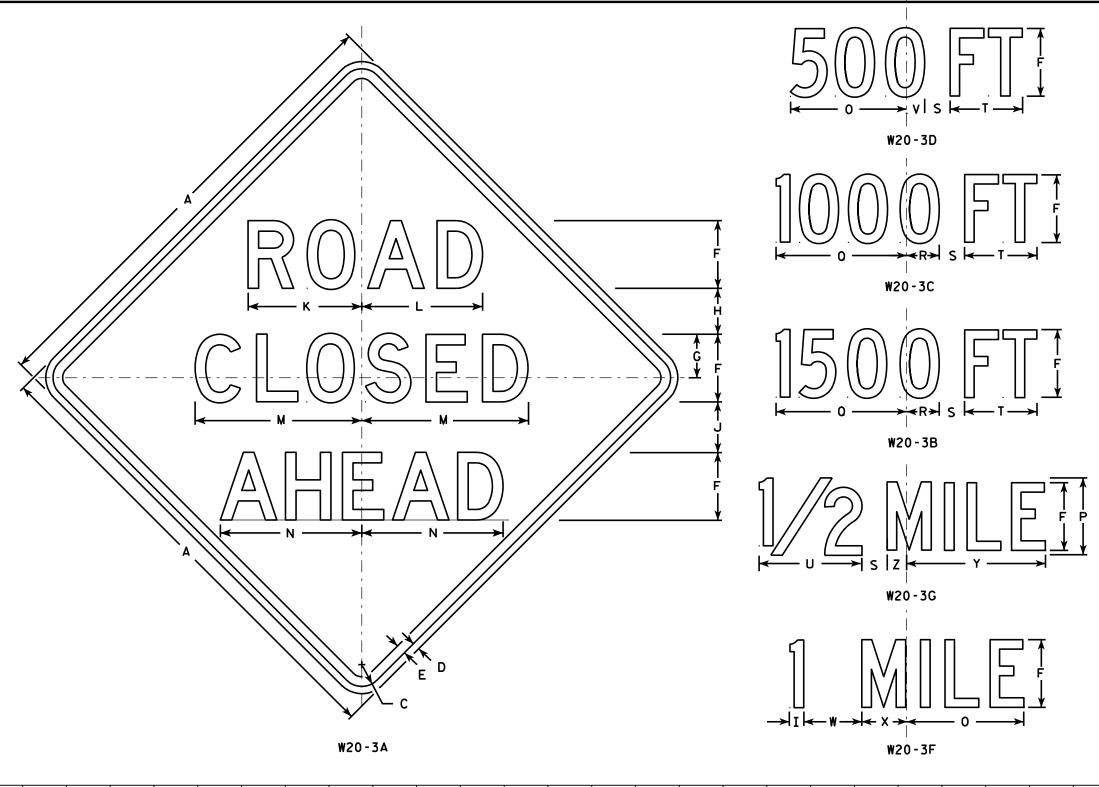

- Sign is Type II Type F Reflective reference WIS DOT Standard Specification for HIGHWAY and STRUCTURE CONSTRUCTION latest edition.
- 2. Color:

Background - Orange Message - Black

- 3. Message Series see note 5
- 4. Corners may be square or rounded when base material is plywood but borders shall be rounded as shown. When base material is metal, the corners and borders shall be rounded.
- 5. Lines 1 and 2 are Series D.
 Line 3 is Series D for AHEAD and
 Series C for all other distances.

С	D	E	F	G	Н	I	J	K	L	М	N	0	Р	0	R	S	T	U	٧	W	Х	Y	Z	Areo sq. ft.
1 %	5/8	₹4	5	3 %	3 1/2	1 1/8	4	8 %	8 %	12 1/2	11	9	6	10 1/8	2 1/2	1 %	5 %	8	1 3/8	4 1/2	3 1/2	10 ¾	1 3/4	9.0
2 1/4	3/4	1	7	4 1/2	4 3/4	1 1/2	5 1/4	11 3/4	12 1/2	17 1/4	14 %	12	8	13 ½	3 3/8	2 5/8	7 1/2	10 %	1 1/8	6	4 %	14 3/8	2 3/8	16.0
2 1/4	3∕4	1	7	4 1/2	4 3/4	1 1/2	5 1/4	11 3/4	12 1/2	17 1/4	14 %	12	8	13 1/2	3 3/8	2 5/8	7 1/2	10 %	1 1/8	6	4 %	14 3/8	2 3/8	16.0
2 1/4	3∕4	1	7	4 1/2	4 3/4	1 1/2	5 1/4	11 ¾	12 1/2	17 1/4	14 %	12	8	13 1/2	3 3/8	2 5/8	7 1/2	10 %	1 1/8	6	4 %	14 3/8	2 3/8	16.0
2 1/4	3∕4	1	7	4 1/2	4 3/4	1 1/2	5 1/4	11 ¾	12 1/2	17 1/4	14 %	12	8	13 1/2	3 3/8	2 5/8	7 1/2	10 %	1 1/8	6	4 %	14 3/8	2 3/8	16.0
2 1/4	3/4	1	7	4 1/2	4 3/4	1 1/2	5 1/4	11 3/4	12 1/2	17 1/4	14 %	12	8	13 ½	3 3/8	2 5/8	7 1/2	10 %	1 1/8	6	4 %	14 3/8	2 3/8	16.0

COUNTY:

STANDARD SIGN W20-3A, B, C, D, F & G

WISCONSIN DEPT OF TRANSPORTATION

APPROVED M 441 // // //

DATE 3/18/11 PLATE NO. W20-3.7

SHEET NO:

HWY:

а 36

48

48

PROJECT NO:

2M

3

4

5


PLOT BY: mscj9h




- Sign is Type II Type F Reflective reference WIS DOT Standard Specification for HIGHWAY and STRUCTURE CONSTRUCTION latest edition.
- 2. Color:


Background - Orange Message - Black

- 3. Message Series C
- 4. Corners may be square or rounded when base material is plywood but borders shall be rounded as shown. When base material is metal, the corners and borders shall be rounded.

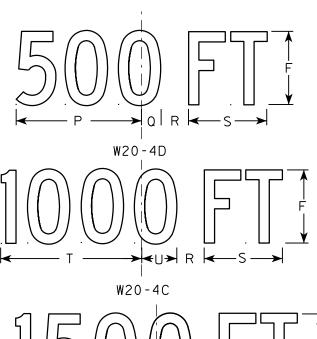

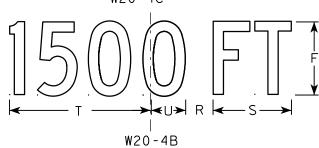



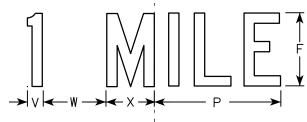

W20	-4F

Α	В	С	D	E	F	G	Н	I	J	K	L	М	N	0	Р	0	R	S	Т	U	٧	W	Х	Y	Z	Area sq. ft.
36		1 5/8	5/8	3/4	5	2 3/8	6	3 3/4	10 3/8	2 3/8	8	13 ½	7	8 1/8	9	1 3/8	1 1/8	5 %	10 1/8	2 1/2	1 1/8	4 1/2	3 ½	10 ¾	1 3/4	9.0
48		2 1/4	3/4	1	7	3 1/8	8	5 1/4	14 5/8	3 1/4	10 %	17 3/4	9 3/4	12 %	12	1 1/8	2 %	7 1/2	13 ½	3 3/8	1 1/2	6	4 5/8	14 3/8	2 3/8	16.0
48		2 1/4	3/4	1	7	3 1/8	8	5 1/4	14 5/8	3 1/4	10 %	17 ¾	9 3/4	12 %	12	1 1/8	2 %	7 1/2	13 ½	3 3/8	1 1/2	6	4 5/8	14 3/8	2 3/8	16.0
48		2 1/4	3/4	1	7	3 1/8	8	5 1/4	14 5/8	3 1/4	10 %	17 3/4	9 3/4	12 %	12	1 1/8	2 %	7 1/2	13 ½	3 3/8	1 1/2	6	4 5/8	14 3/8	2 3/8	16.0
48		2 1/4	3/4	1	7	3 1/8	8	5 1/4	14 5/8	3 1/4	10 %	17 ¾	9 3/4	12 %	12	1 1/8	2 %	7 1/2	13 1/2	3 3/8	1 1/2	6	4 5/8	14 3/8	2 3/8	16.0
48		2 1/4	3/4	1	7	3 1/8	8	5 1/4	14 5/8	3 1/4	10 %	17 3/4	9 3/4	12 5/8	12	1 1/8	2 5/8	7 1/2	13 ½	3 %	1 1/2	6	4 5/8	14 3/8	2 3/8	16.0
	48 48 48 48	48 48 48 48	48 2 1/4 48 2 1/4 48 2 1/4 48 2 1/4	48 2 1/4 3/4 48 2 1/4 3/4 48 2 1/4 3/4 48 2 1/4 3/4 48 2 1/4 3/4	48 2 \(\frac{1}{4} \) \(\frac{3}{4} \) 1 48 2 \(\frac{1}{4} \) \(\frac{3}{4} \) 1 48 2 \(\frac{1}{4} \) \(\frac{3}{4} \) 1 48 2 \(\frac{1}{4} \) \(\frac{3}{4} \) 1	48 2 1/4 3/4 1 7 48 2 1/4 3/4 1 7 48 2 1/4 3/4 1 7 48 2 1/4 3/4 1 7 48 2 1/4 3/4 1 7	48 2 1/4 3/4 1 7 3 1/8 48 2 1/4 3/4 1 7 3 1/8 48 2 1/4 3/4 1 7 3 1/8 48 2 1/4 3/4 1 7 3 1/8 48 2 1/4 3/4 1 7 3 1/8	48 2 1/4 3/4 1 7 3 1/8 8 48 2 1/4 3/4 1 7 3 1/8 8 48 2 1/4 3/4 1 7 3 1/8 8 48 2 1/4 3/4 1 7 3 1/8 8 48 2 1/4 3/4 1 7 3 1/8 8	48 2 1/4 3/4 1 7 3 1/8 8 5 1/4 48 2 1/4 3/4 1 7 3 1/8 8 5 1/4 48 2 1/4 3/4 1 7 3 1/8 8 5 1/4 48 2 1/4 3/4 1 7 3 1/8 8 5 1/4 48 2 1/4 3/4 1 7 3 1/8 8 5 1/4	48 2 1/4 3/4 1 7 3 1/8 8 5 1/4 14 5/8 48 2 1/4 3/4 1 7 3 1/8 8 5 1/4 14 5/8 48 2 1/4 3/4 1 7 3 1/8 8 5 1/4 14 5/8 48 2 1/4 3/4 1 7 3 1/8 8 5 1/4 14 5/8 48 2 1/4 3/4 1 7 3 1/8 8 5 1/4 14 5/8	48 2 1/4 3/4 1 7 3 1/8 8 8 5 1/4 14 5/8 3 1/4 48 2 1/4 3/4 1 7 3 1/8 8 8 5 1/4 14 5/8 3 1/4 48 2 1/4 3/4 1 7 3 1/8 8 5 1/4 14 5/8 3 1/4 48 2 1/4 3/4 1 7 3 1/8 8 5 1/4 14 5/8 3 1/4 48 2 1/4 3/4 1 7 3 1/8 8 5 1/4 14 5/8 3 1/4 48 2 1/4 3/4 1 7 3 1/8 8 5 1/4 14 5/8 3 1/4	48 2 1/4 3/4 1 7 3 1/8 8 5 1/4 14 5/8 3 1/4 10 5/8 48 2 1/4 3/4 1 7 3 1/8 8 5 1/4 14 5/8 3 1/4 10 5/8 48 2 1/4 3/4 W20-4A

STANDARD SIGN W20-4A, B, C, D, F & G

WISCONSIN DEPT OF TRANSPORTATION

APPROVED

Matthew R Rauch

For State Traffic Engineer

DATE 3/18/11

SHEET NO:

PROJECT NO:

Ε

PLATE NO. W20-4.9

- 1. Sign is Type II Type F Reflective reference WIS DOT Standard Specification for HIGHWAY and STRUCTURE CONSTRUCTION latest edition.
- 2. Color:

Background - Orange Message - Black

3. Corners may be square or rounded when base material is plywood but borders shall be rounded as shown. When base material is metal, the corners and borders shall be rounded.

	G H- + D C
W20-	- (A

HWY:

SIZE	Α	В	С	D	E	F	G	Н	I	J	К	L	М	N	0	Р	0	R	S	Т	U	V	W	х	Y	Z	Area sq. ft.
1	36		1 5/8	5/8	₹4		2 3/4	13 1/2	14 %																		9.00
2S	48		2 1/4	3/4	1		3 3/4	18	19 1/2																		16.00
2M	48		2 1/4	3/4	1		3 3/4	18	19 1/2																		16.00
3	48		2 1/4	3/4	1		3 3/4	18	19 1/2																		16.00
4	48		2 1/4	3/4	1		3 3/4	18	19 ½																		16.00
5	48		2 1/4	₹4	1		3 3/4	18	19 ½																		16.00

COUNTY:

STANDARD SIGN W20-7A

WISCONSIN DEPT OF TRANSPORTATION

APPROVED Matther & Rawl

DATE 3/18/11 PLATE NO. W20-7A.5

SHEET NO:

PROJECT NO:

PLOT NAME :